Name Josephine Hildebrandt **Service No.** 83

Address #15 Barnes Pl

Location Nov. 13 1978

Kind of Pipe AC **Size** **Size of Main**

Repair—Renewal—New Service Valeri #3096 **Location** Nov. 13 1978

Date	Material	Amount	Total	Date		Amount
8/24/78	16' of 6" ACP @	$16.53	$264.48	10-24-78	Deposit	264 48
10/26/78	85' of 6" Transite 5' of 4" Cast Iron					

DATE _____

TOWN OF LEXINGTON — BOARD OF PUBLIC WORKS

SEWER DIVISION

Sketch of Service Here 15

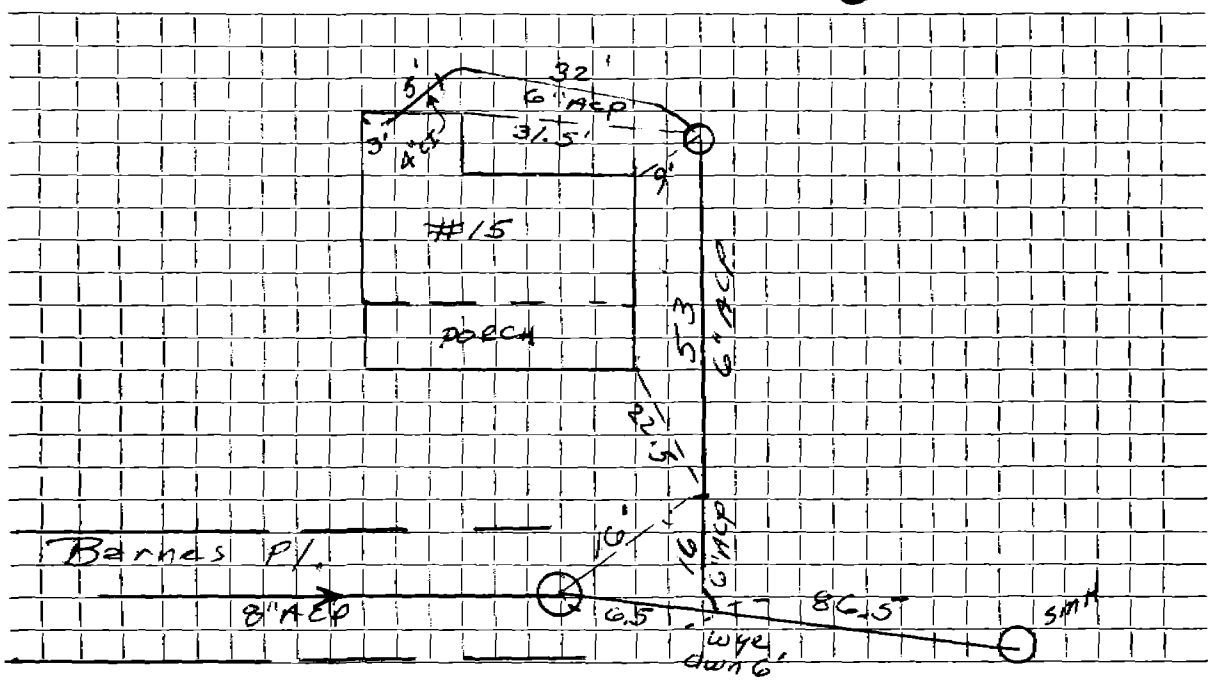

Connection made in ....Barnes Pl..... ~~Street.~~ Work completed .....

Remarks: .....

.....

.....