Name Norman Magnanti **Service No.** 225

Address 18 Baskin Road

Location Comm. 3-3-58

Kind of Pipe **Size** **Size of Main**

~~**Repair**~~ ~~**Renewal**~~ **New Service** **Location**

Date	Material	Amount	Total	Date		Amount
12/26/57	Labor	32 16		12-4-57	Deposit	$150 00
	10% overhead	3 22	35 38	3-3-58	Refund	57 08
	49' - 6" Transite Pipe @ .70		34.30			$ 92 92
	1 - 6" 22½° Transite Elbow		2 24			
	3 hrs. Town Shovel @ 6.50		19 50			
	2 hrs. Trucking @ .75		1 50			
			92 92			
	Labor					

H.B.M.18501

TOWN OF LEXINGTON—DEPT. OF PUBLIC WORKS

SEWER DIVISION

DATE..... NO. .....

The undersigned applies for the construction of a particular sewer connecting No..... Street and hereby agrees to comply with the Rules and Regulations governing the construction and use of Particular Sewers, as now or at any future time established by the Board of Selectmen.

Am't of estimate $.....

Am't Paid $.....

..... Owner

Sketch of Service Here

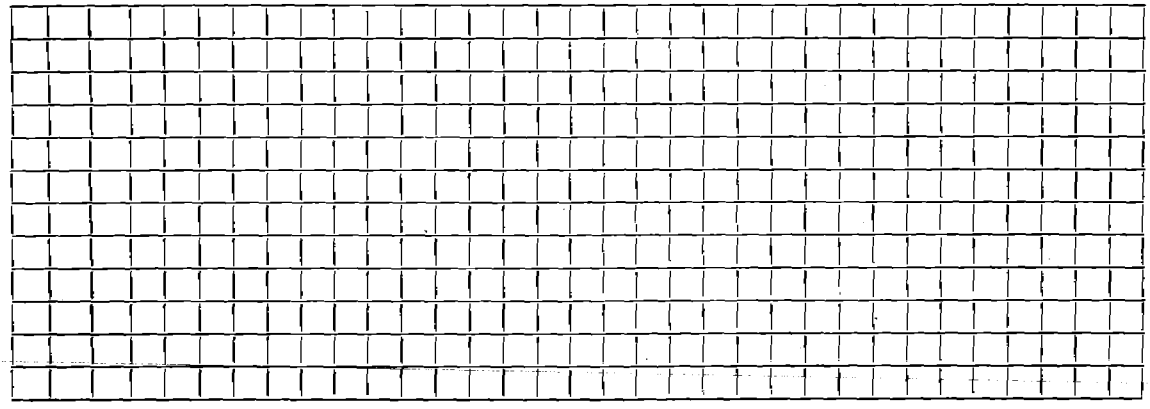

Connection made in..... Street. Work completed.....19..

Remarks: