Name Sigmar Tullman **Service No.** 155

Address 4 Bates Road

Location

Kind of Pipe AC **Size** 6" **Size of Main** 8"

Repair—Renewal—New Service Valeri Const. #2790 **Location** AUG 16 1976

Date		Material	Amount		Total		Date			Amount	
7-24	75	19'-6" AC at	$10.00	=	$190.	00	12/5/75		Deposit	190	00
12/12/75	38'	6" Transite Pipe									
	7'	4" Cast Iron Pipe									

1.B.W.1.8FC1

DATE _____

TOWN OF LEXINGTON — BOARD OF PUBLIC WORKS

SEWER DIVISION

Sketch of Service Here **4**

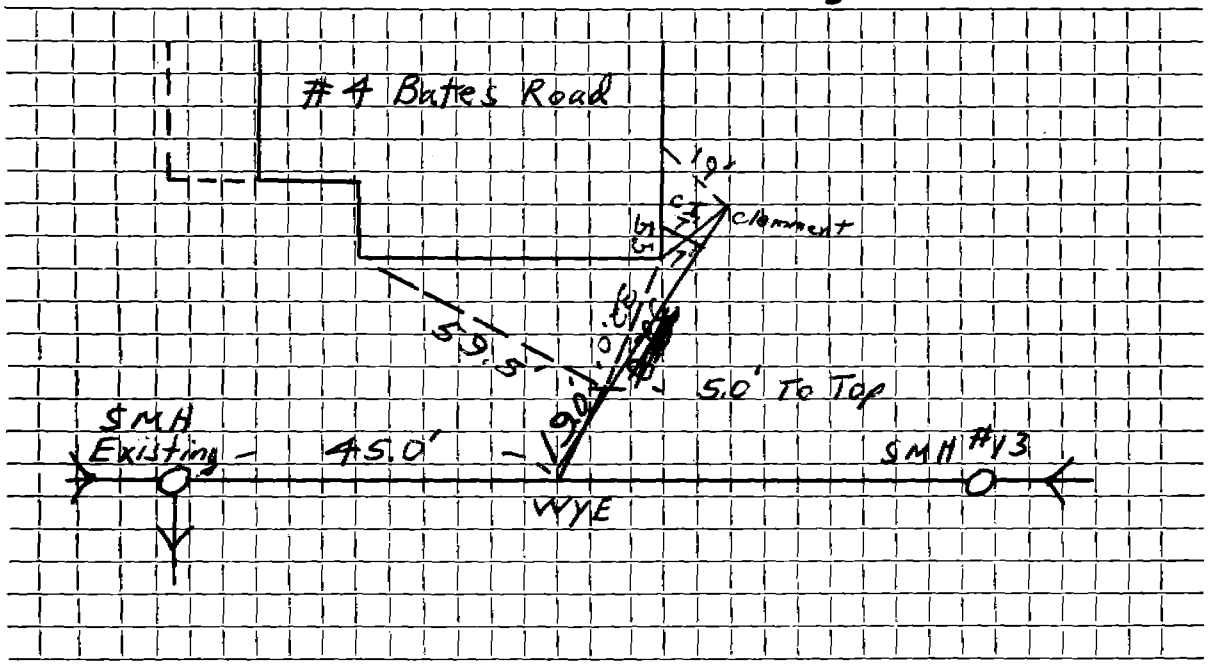

Connection made in #4 Bates ..... Street. Work completed 12/12/75

Remarks: .....