Name **Service No.**

Address 9 BATES RD

Location

Kind of Pipe **Size** **Size of Main**

Repair **Renewal** **New Service** **Location**

Date		Material	Amount	Total	Date	off RD.	Amount
5/17/00	60'	6" PVC			7/23/87	A.C. PIPE	
	7'	4" PVC					
	4X6	FERNCO					
	6"	ACX PVC FERNCO					

DATE _____

TOWN OF LEXINGTON — BOARD OF PUBLIC WORKS

SEWER DIVISION

Sketch of Service Here

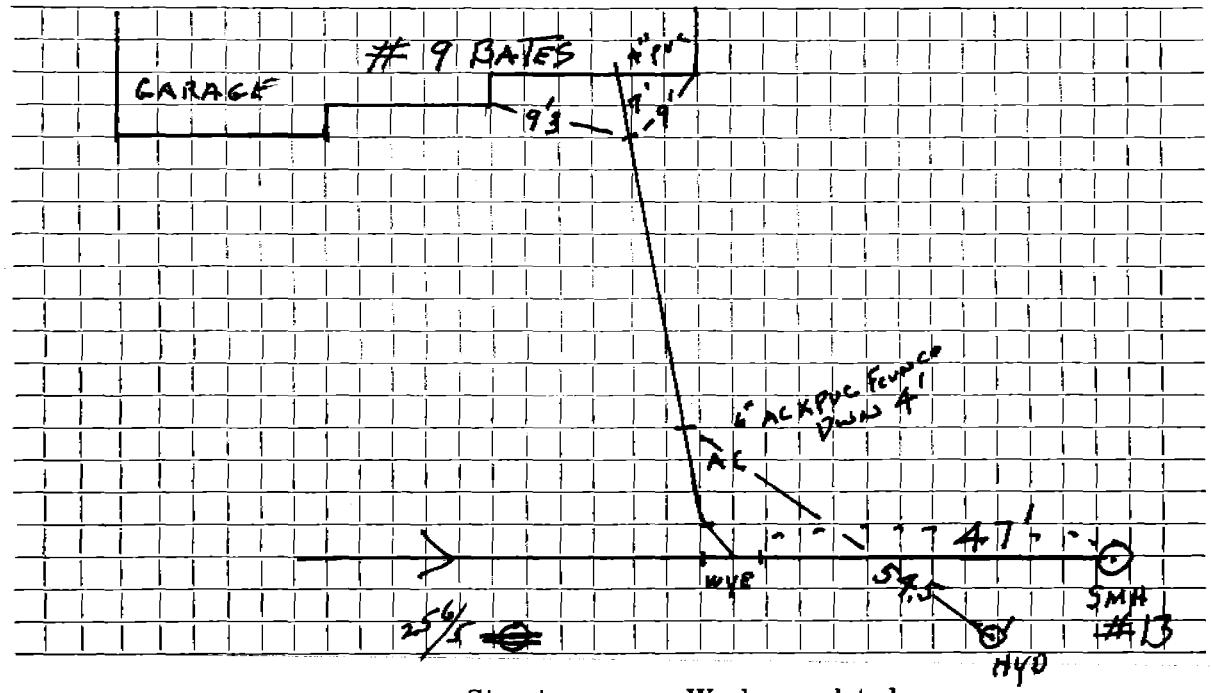

Connection made in ..... Street. Work completed .....

Remarks: MADE DRAIN REPAIR TO RAISE SEWER 8" SEC. INTO 10" PVC