Name Heidke Realty Trust **Service No.**

Address # 1 BATTLEVIEW CIR

Location

Kind of Pipe PVC **Size** 6" **Size of Main** 8" PVC

~~**Repair—Renewal**~~**—New Service** Arlex Oil #3771 **Location**

Date		Material	Amount	Total	Date			Amount
1/13/83	72'	x 6" P.V.C.						
	10"	x 4" P.V.C.						
	1	6" x 4" Donut						
	1	45° x 6" Elbow					OUTSIDE	
					1/13/83	60'	x 6" P.V.C.	

DATE 10-8-82

TOWN OF LEXINGTON — BOARD OF PUBLIC WORKS

SEWER DIVISION

Sketch of Service Here

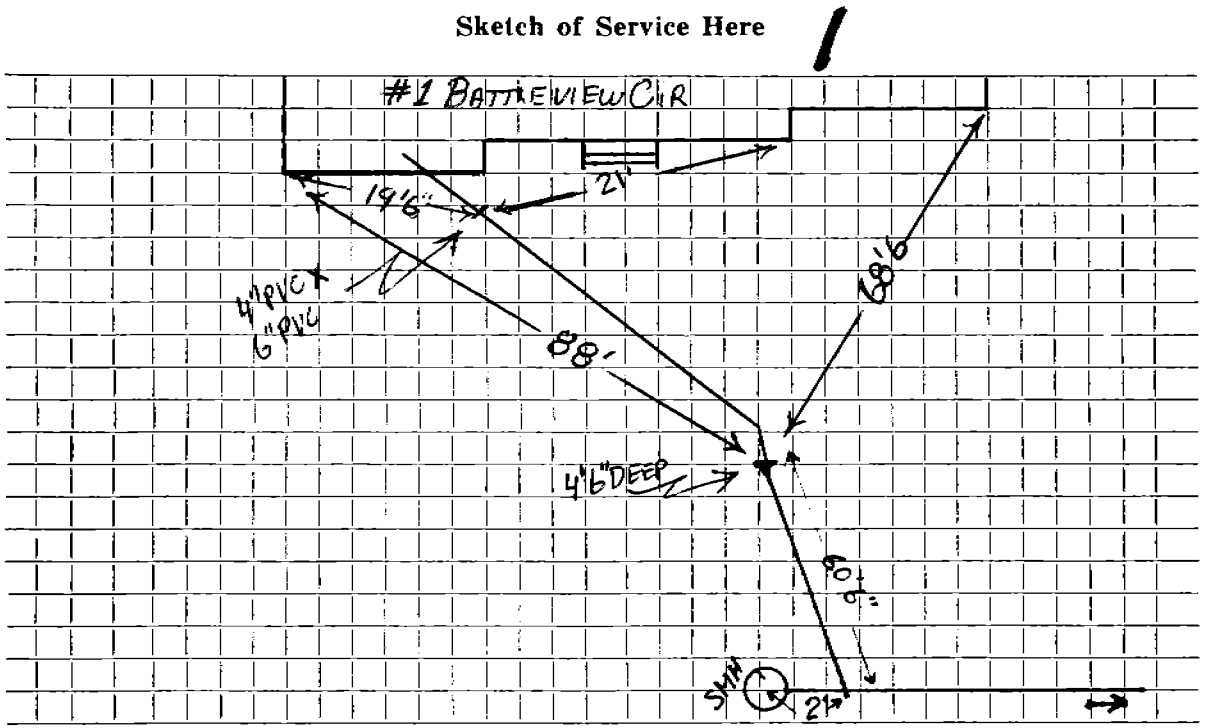

Connection made in BATTLEVIEW CIR. Street. Work completed 1-13-83

Remarks: TEE "WYE" TWO FEET DOWN FROM SMH.