Name Leo Treitler **Service No.**

Address 218 Bedford Street

Location

Kind of Pipe **Size** **Size of Main**

Repair—Renewal—New Service Russ SibleyA429 **Location**

Date		Material	Amount		Total		Date			Amount	
10-4-66	58'	6" Transite pipe									

H.B.M.18501

DATE _____

TOWN OF LEXINGTON — BOARD OF PUBLIC WORKS

SEWER DIVISION

Sketch of Service Here 218

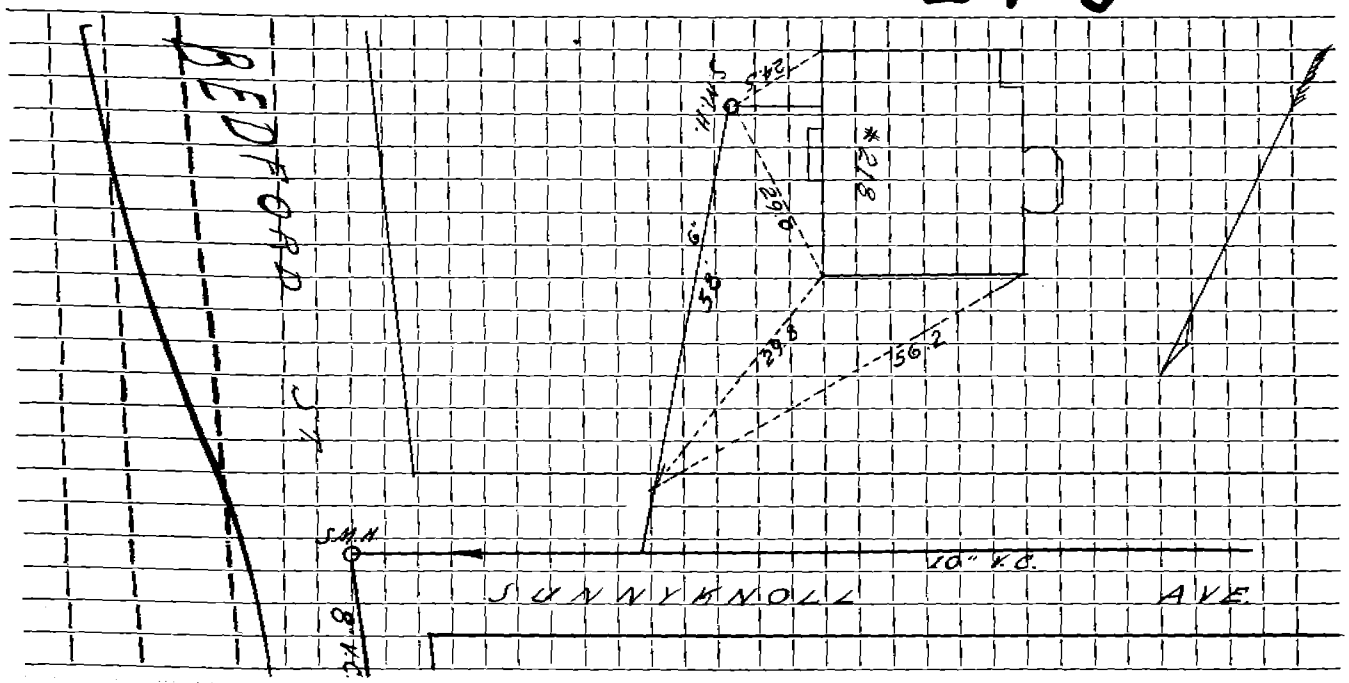

Connection made in ..... Street. Work completed .....

Remarks: .....

.....

.....