Name Robert G. Allen **Service No.** 21

Address 253 Bedford Street

Lexington, Mass. **Location** 253 Bedford Street

Kind of Pipe Com. June 1, 1948 **Size** **Size of Main**

~~Repair~~ ~~Renewal~~ **New Service** **Location**

Date	Material	Amount	Total	Date		Amount
Apr. 10, '48	Labor	58 73	58 73	April 23 '48	Deposited	125 00
	10% Overhead		5 87	June 3 '48	Refunded	40 98
	56' - 6" Sewer Pipe @.26		14 56			84 02
	Joint Compound		3 36			
	Trucking 2 hrs. @ .75		1 50			
			84 02			
	Labor					

HP-6411

TOWN OF LEXINGTON—DEPT. OF PUBLIC WORKS

SEWER DIVISION

DATE ..... NO. .....

The undersigned applies for the construction of a particular sewer connecting No. ..... Street and hereby agrees to comply with the Rules and Regulations governing the construction and use of Particular Sewers, as now or at any future time established by the Board of Selectmen.

Am't of estimate $.....

Am't Paid $.....

..... Owner

Sketch of Service Here

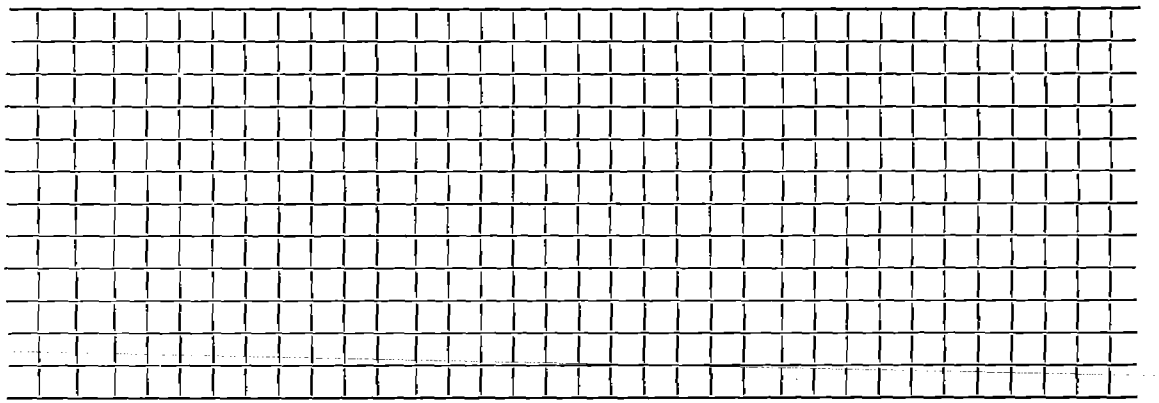

Connection made in ..... Street. Work completed ..... 19..

Remarks: