Name Edward McGovern

Service No. 16

Address 260 Bedford Street

Lexington, Mass.

Location 260 Bedford Street

Kind of Pipe

Size

Size of Main

~~Repair~~ ~~Renewal~~ New Service

Com. June 27, 1949

Location

Date	Material	Amount	Total	Date		Amount
Apr. 25, '49	Labor	55 53		April 5 '49	Deposited	125 0
26	"	12 53	68 06	June 30 '49	Refunded	4 [illegible]
	10% Overhead		6 81		No Charge	120 36
	50' - 6" Sewer Pipe @.27		13 50	Apr. 26, '49	Labor	45 0
	1 - 6" 1.8 Bend		1 49		14' - 6" Sewer Pipe @.27	3 7
	Joint Compound		3 00		1 - 6" 1/8 Bend	1 4
	Littlefield Shovel 3 hrs.@7.00		21 00		Joint Compound	9
	Trucking 2 hrs. @.75		1 50		Littlefield Shovel 4 hrs.@7.00	28 0
	Patching 5 x 3		5 00		Trucking 1 hr. @.75	7
			120 36		Patching 15 x 3	15 0
						94 9
	Labor					

HP-7919

TOWN OF LEXINGTON—DEPT. OF PUBLIC WORKS

SEWER DIVISION

DATE . . . . . NO. . . . . .

The undersigned applies for the construction of a particular sewer connecting No. . . . . Street and hereby agrees to comply with the Rules and Regulations governing the construction and use of Particular Sewers, as now or at any future time established by the Board of Selectmen.

Am't of estimate $. . . . . .

Am't Paid $. . . . . .

. . . . . Owner

Sketch of Service Here

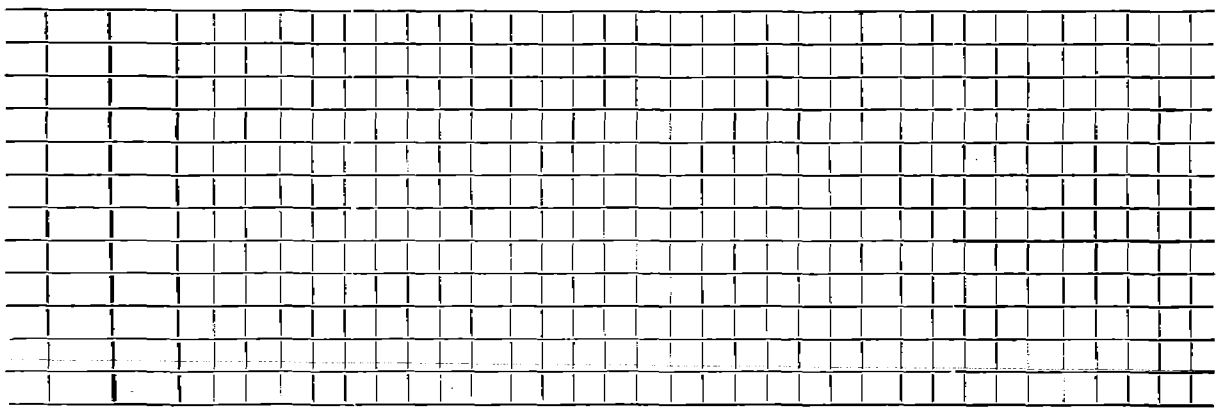

Connection made in . . . . . Street. Work completed . . . . . 19. .

Remarks: