Name **Service No.**

Address 3 Bicentennial Drive

Location

Kind of Pipe **Size** **Size of Main**

~~**Repair Renewal**~~ **New Service** Eagle **Location**

Date		Material	Amount	Total	Date		Amount
7/29/77	19'	6" A.C.P.					
	10'	4" C.I.					

H.B.N.-18501

DATE _____

TOWN OF LEXINGTON — BOARD OF PUBLIC WORKS

SEWER DIVISION

Sketch of Service Here **3**

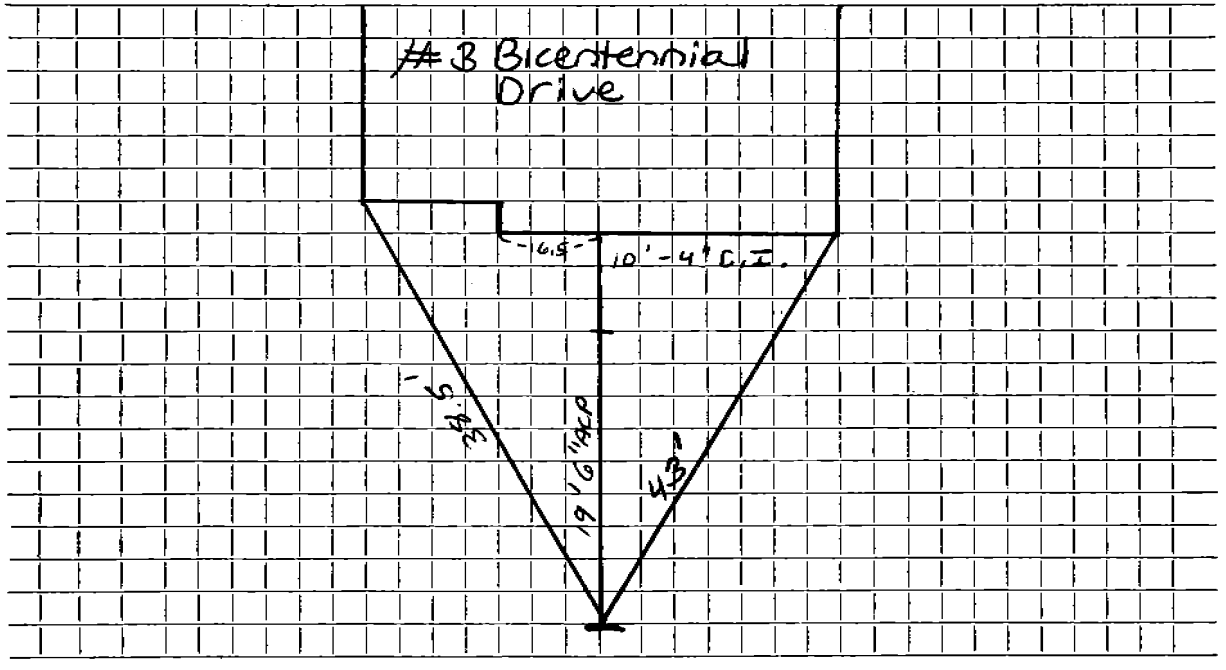

Connection made in ..... Street. Work completed .....

Remarks: .....

.....

....