Name

Service No.

Address #8 BICENTENNIAL DR.

Location

Kind of Pipe AC

Size 6"

Size of Main

Repair—Renewal—New Service

Location

Date	Material	Amount	Total	Date		Amount
7/6/77	42'-6" ACP					
	10'-4" CI					

F.B.S.18501

DATE _____

TOWN OF LEXINGTON — BOARD OF PUBLIC WORKS

SEWER DIVISION

Sketch of Service Here 8

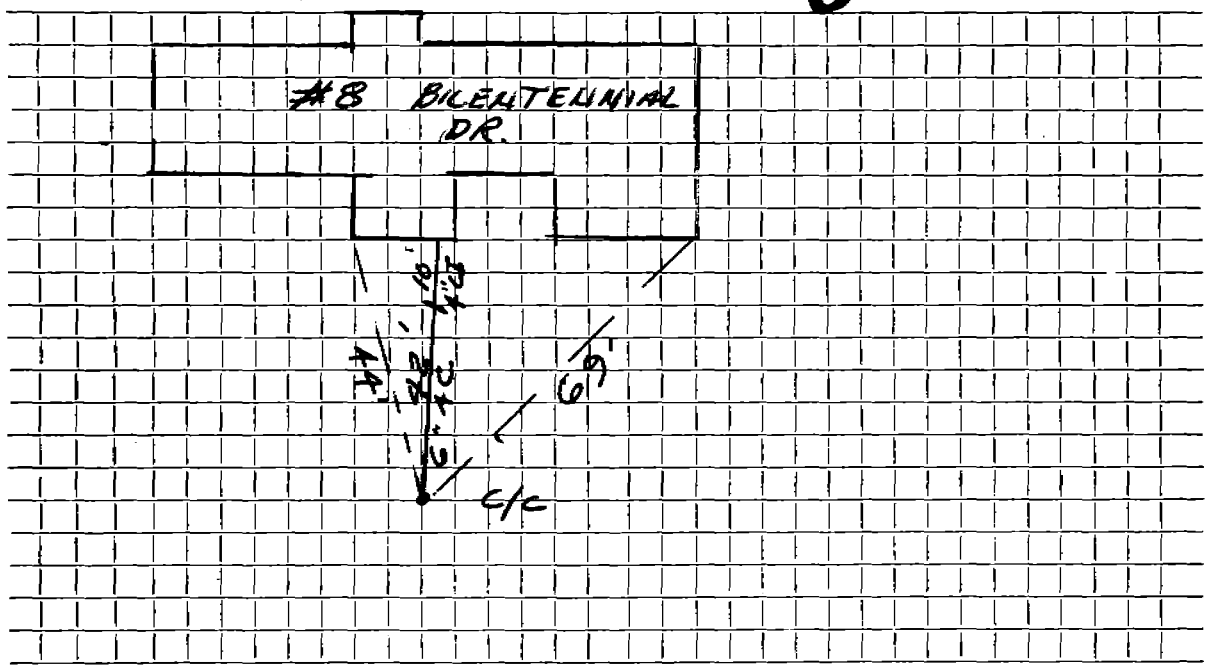

Connection made in ..... Street. Work completed .....

Remarks: .....

.....

.....