Name J. Frank Busa **Service No.**

Address 19 Birch Hill Lane

Lot # 21 **Location**

Kind of Pipe **Size** **Size of Main**

Repair—Renewal—New Service Glynn #1268 Lucente #801 **Location**

Date		Material	Amount		Total		Date			Amount	
1968	40'	6" Transite pipe									
12-14-68	32'	6" Transite pipe									
	10'	4" Cast Iron									

H.B.M.18501

DATE _____

TOWN OF LEXINGTON — BOARD OF PUBLIC WORKS

SEWER DIVISION

Sketch of Service Here 19

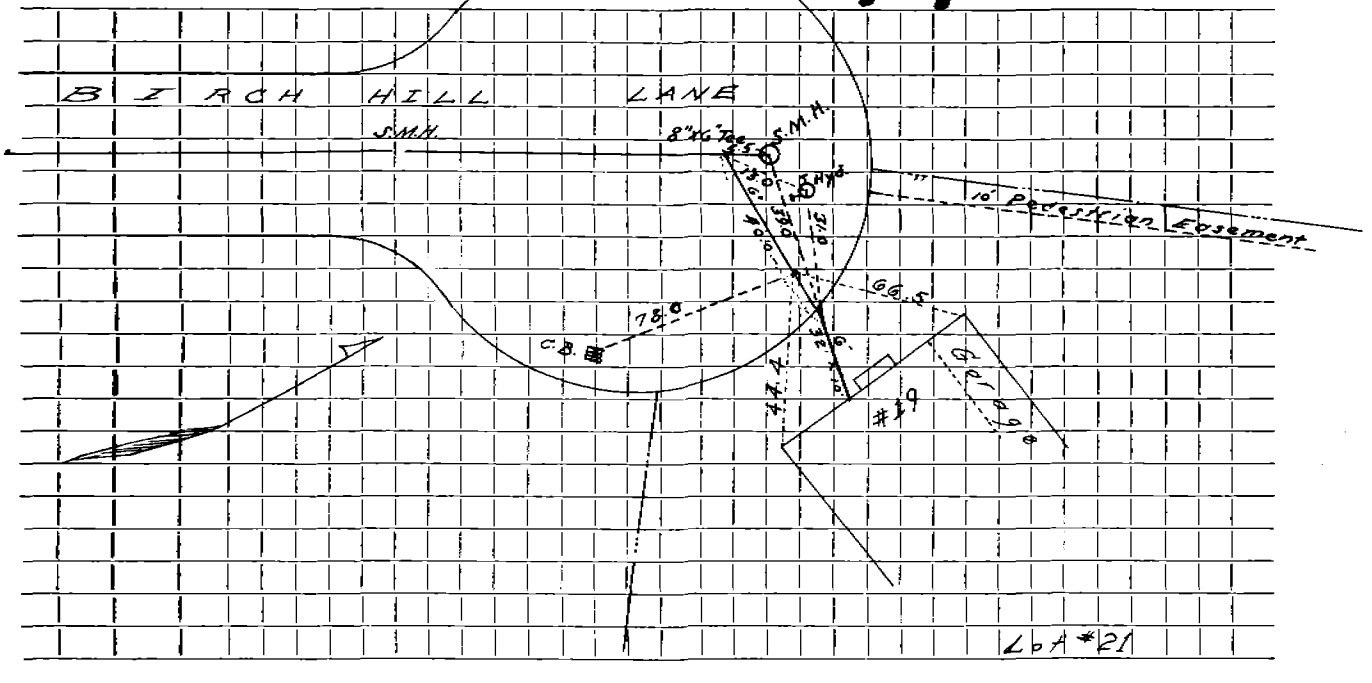

Connection made in ..... Street. Work completed .....

Remarks: .....

.....

.....