Name **Service No.**

Address Lot #101 B120 HILL RD.

2

Location

Kind of Pipe A.C. **Size** 6" **Size of Main** 8"

Repair—Renewal—New Service **Location**

Date	Material	Amount		Total		Date			Amount	
4/18/80	20 lf 6" AC @	$15.00	=	$300.	00					

DATE 8/5/80

TOWN OF LEXINGTON — BOARD OF PUBLIC WORKS

SEWER DIVISION

Sketch of Service Here

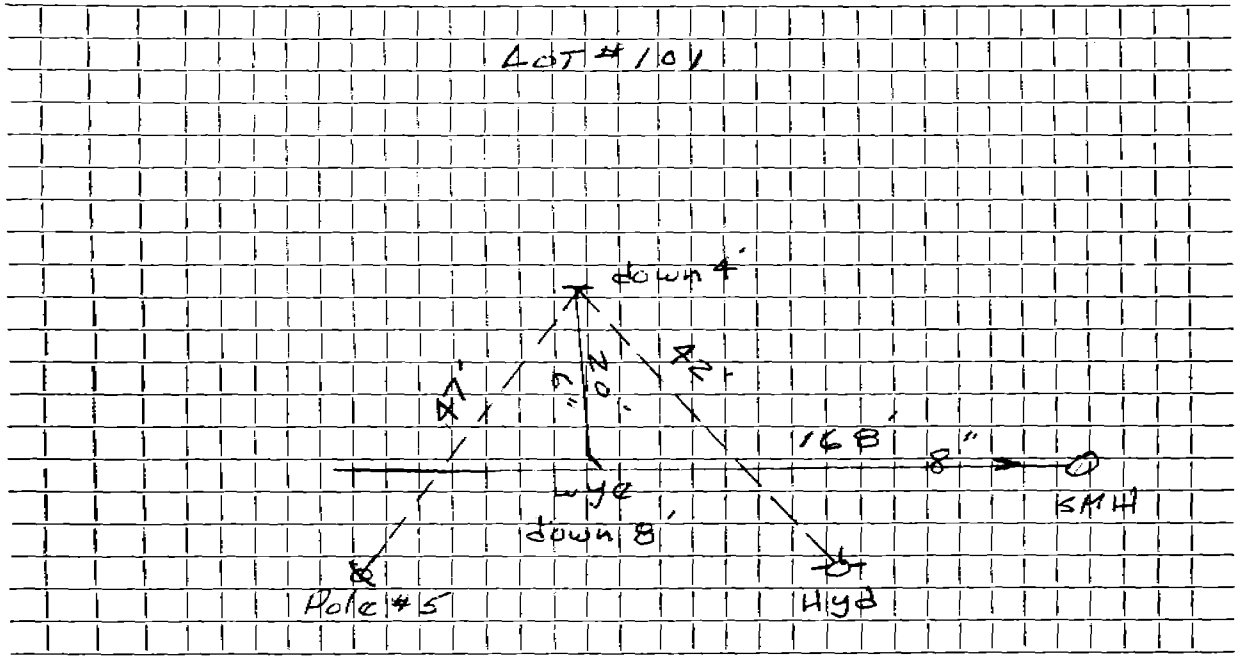

Connection made in BIRD HILL RD. Street. Work completed .....

Remarks: .....