Name

Service No.

Address Lot #97 BIRD HILL RD

Location

Kind of Pipe AC

Size 6"

Size of Main 8"

Repair—Renewal—New Service ✓

Location

Date		Material	Amount		Total		Date			Amount	
12-10-	79	15lf-6"AC @	15.00	=	$225.	00					

DATE _____

TOWN OF LEXINGTON — BOARD OF PUBLIC WORKS

SEWER DIVISION

Sketch of Service Here

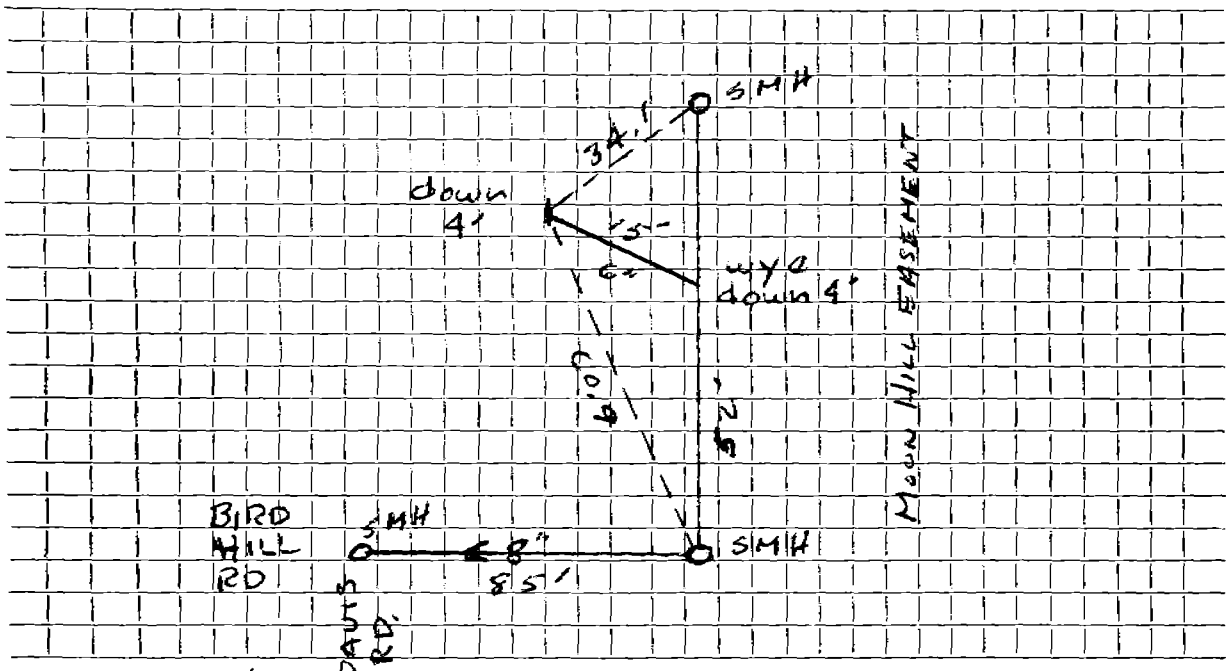

Connection made in Easement Street. Work completed .....

Remarks: .....