**Name** Grace Travers **Service No.**

**Address** 36 Blake Rd.

**Location**

**Kind of Pipe** **Size** **Size of Main**

**Repair—Renewal—New Service** Valeni # 0225 **Location**

| Date | Material | Amount | Total | Date | | | Amount |
|---|---|---|---|---|---|---|---|
| 8/27/93 | 10 LF 4" PVC | | | 8-24-93 | | Paid | 168 00 |
| | 95 LF 6" PVC | | | | | | |
| | 6"x6" WYE C.O. | | | 10- | 67 | | |
| | 6" - 22° ELBOW | | | | 24' | 6" Transite | |
| | 4"x6" FERNCO | | | | | | |
| | 6"x6" FERNCO | | | | | | |

DATE 1/5/94

# TOWN OF LEXINGTON — BOARD OF PUBLIC WORKS

## SEWER DIVISION

Sketch of Service Here **36**

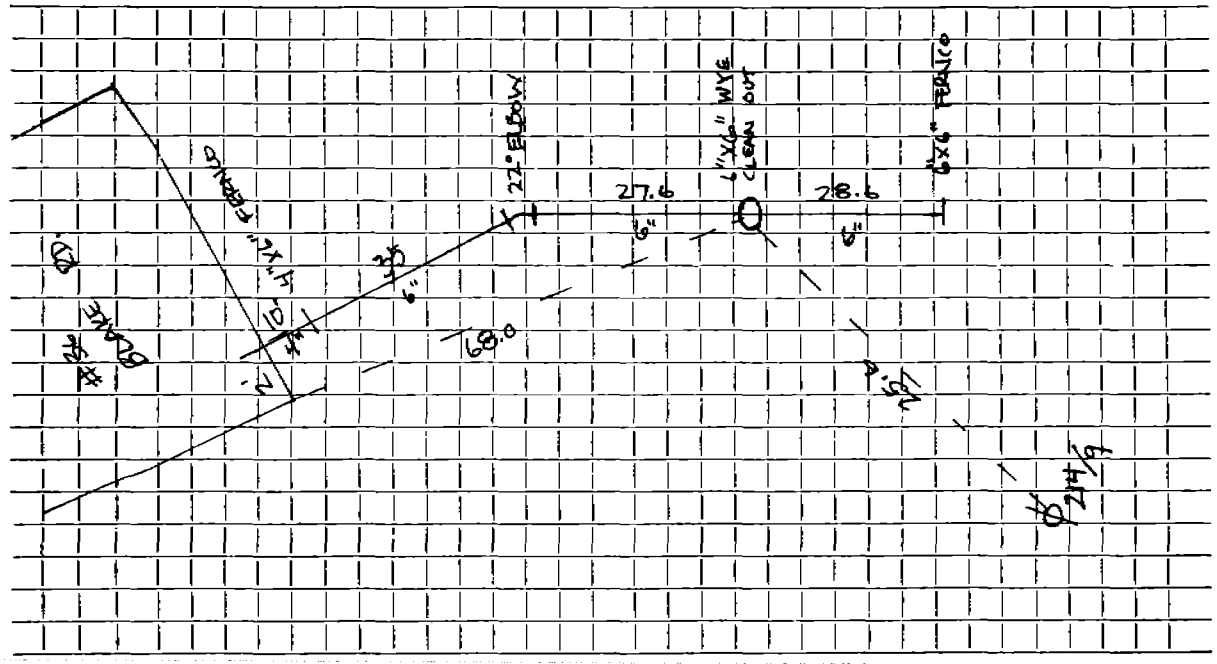


Connection made in ..... Street. Work completed 8/27/93 VARERI CONSTRUCTION.

Remarks: .....