Name S & A Realty Trust **Service No.**

Address 87 Bloomfield Street

Sta. 3+42R Lot #5 **Location**

Kind of Pipe Permit #357 **Size** **Size of Main**

~~Replacement~~ **New Service** J.M.Lucente **Location**

Date		Material	Amount		Total		Date			Amount	
6-25-65	50'	6" Transite pipe									
7-29-67	37'	6" Transite pipe									
	10'	4" Cast Iron pipe									

H.B.M.16501

DATE

TOWN OF LEXINGTON — BOARD OF PUBLIC WORKS

SEWER DIVISION

Sketch of Service Here 87

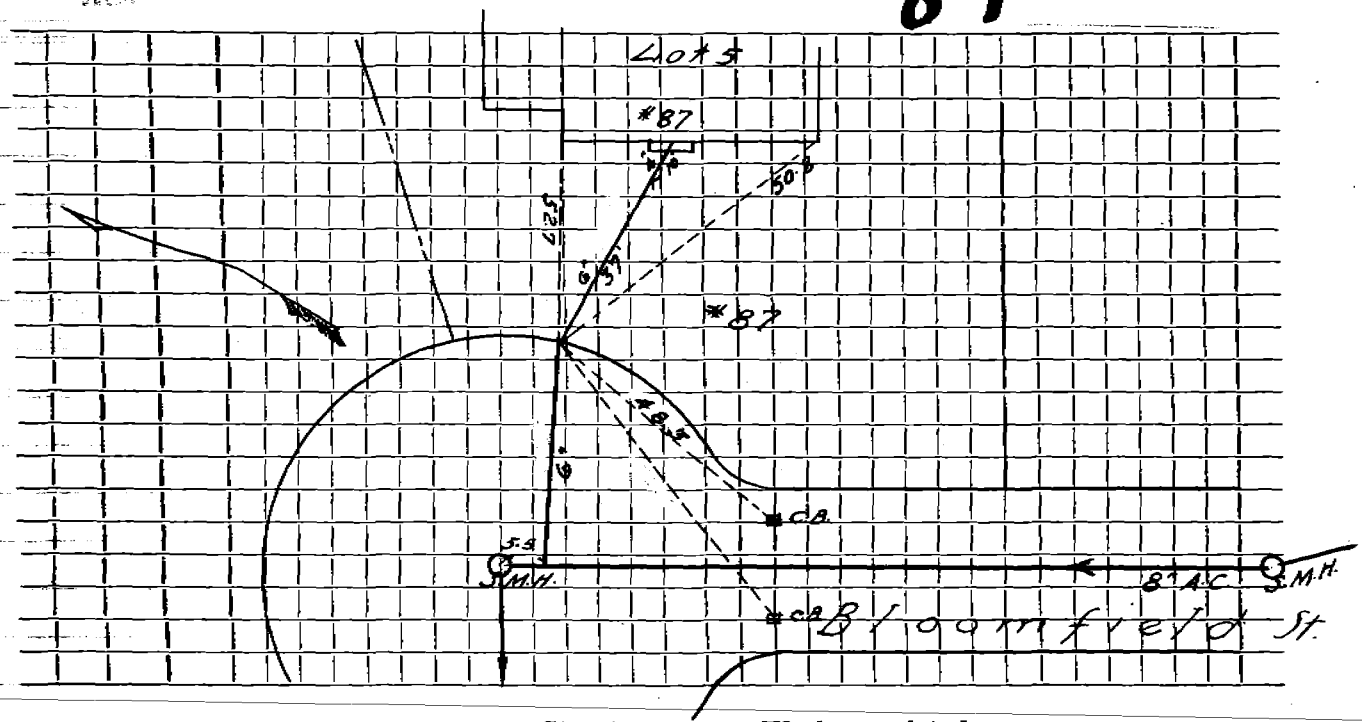

Connection made in ..... Street. Work completed .....

Remarks: .....