Name S & A Realty Trust **Service No.**

Address 89 Bloomfield Street

Sta.4+17R Lot 4 **Location**

Kind of Pipe Permit #356 & A184 **Size** **Size of Main**

~~Service Request~~—**New Service** J.M.Lucente **Location**

Date		Material	Amount		Total		Date			Amount	
6-25-65	83'	6" Transite pipe									
3/4/66	36'	6" Transite pipe									

H.B.M.18501

DATE _____

TOWN OF LEXINGTON — BOARD OF PUBLIC WORKS

SEWER DIVISION
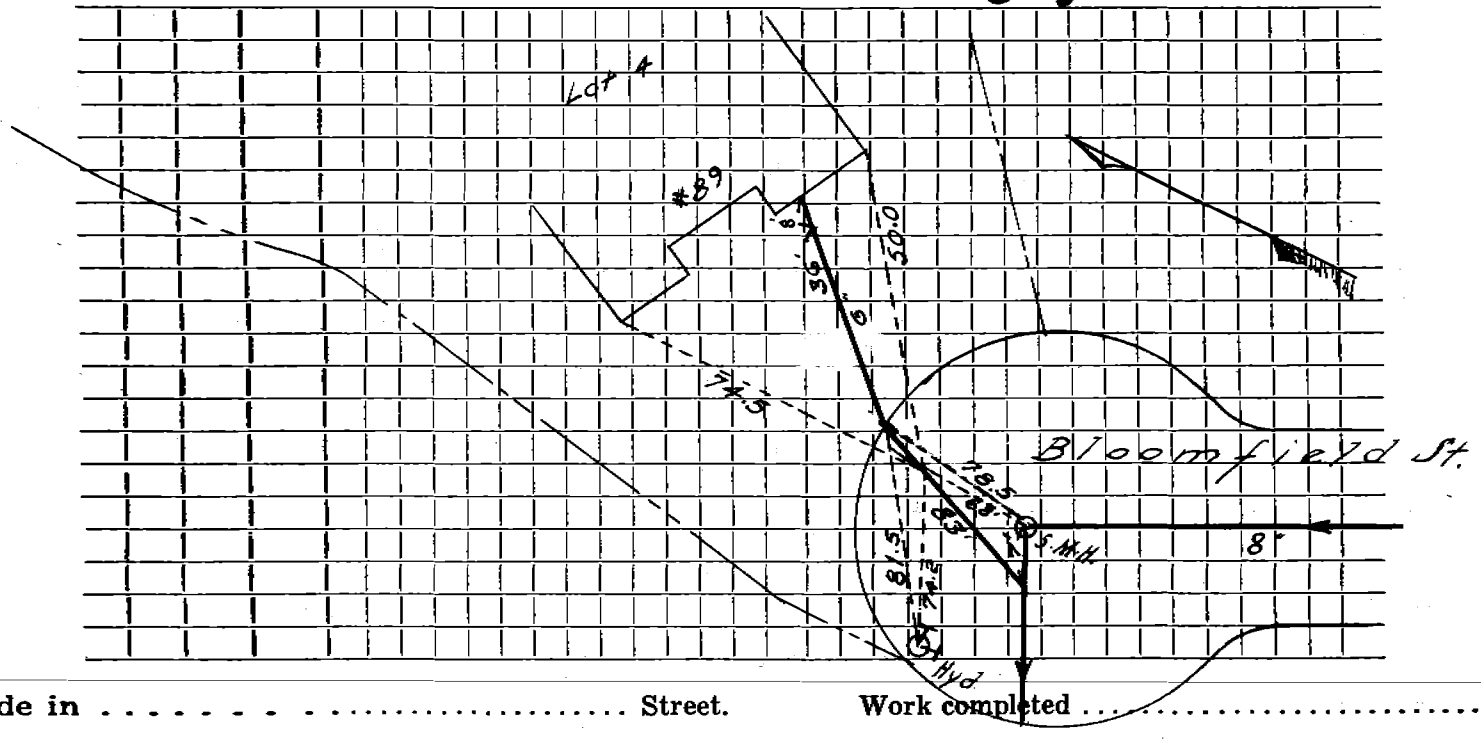
Sketch of Service Here 89