Name Karen H. And Donald J. McManus **Service No.** 13 (76)

Address #18 Blossom Street

Location

Kind of Pipe A.C. **Size** 6" **Size of Main** 8"

Repair—Renewal—New Service Valeri Construction #2815 **Location** AUG 16 1976

Date		Material	Amount		Total		Date			Amount	
9/4/74		20' A.C.	$7.	00	$140.	00	4/6/76		Deposit	140	00
4/13/76	55'	6" Transite Pipe									

R.M.18501

DATE

TOWN OF LEXINGTON — BOARD OF PUBLIC WORKS

SEWER DIVISION

Sketch of Service Here 18

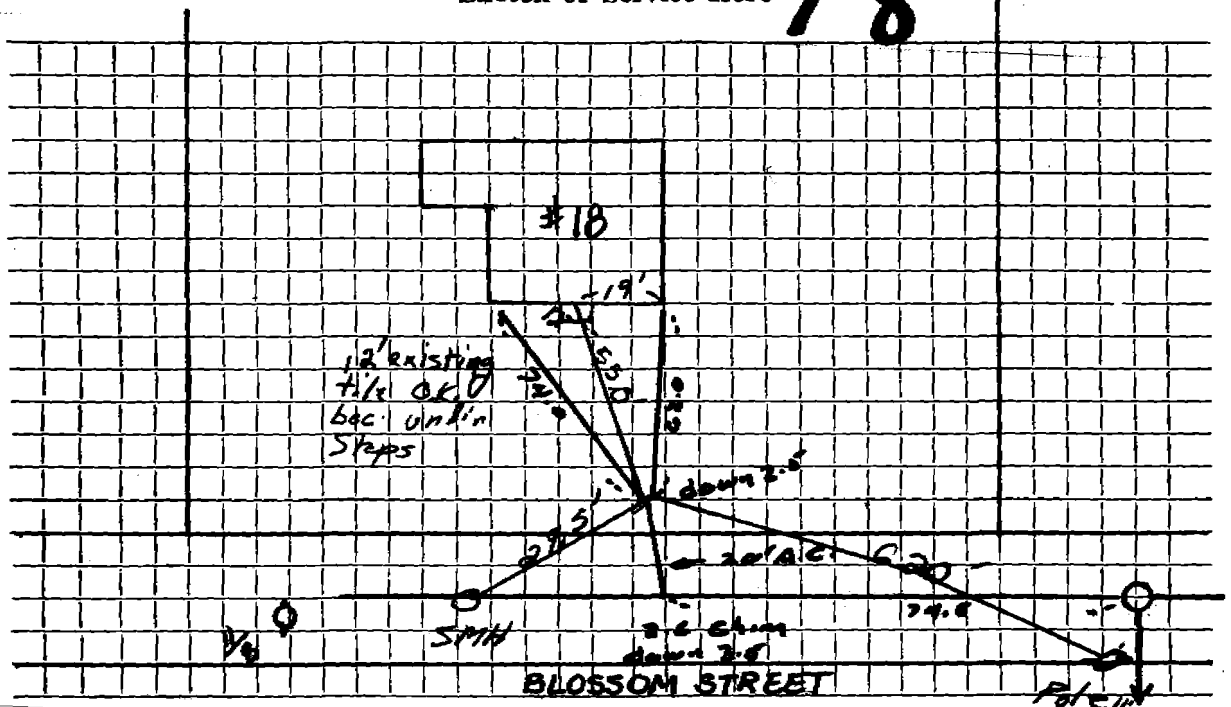

Connection made in 18 Blossom St. Street. Work completed 4/13/76

Remarks: