Name Fine Homes Const. Service No.

Address #5 BLOSSOM ST

Location

Kind of Pipe PVC Size 6" Size of Main 8" ACP

~~[illegible]~~ New Service Redmond #3744 Location

Date		Material	Amount		Total		Date			Amount	
10/1/82	19'	6" P.V.C.									
	10'	4" C.I.P.									
	1	6" x 4" Donut									
									OUTSIDE		
							10/1/82	12'	6" P.V.C.		
								1	8" x 6" Saddle		

DATE 10-4-82

TOWN OF LEXINGTON — BOARD OF PUBLIC WORKS

SEWER DIVISION

Sketch of Service Here 5

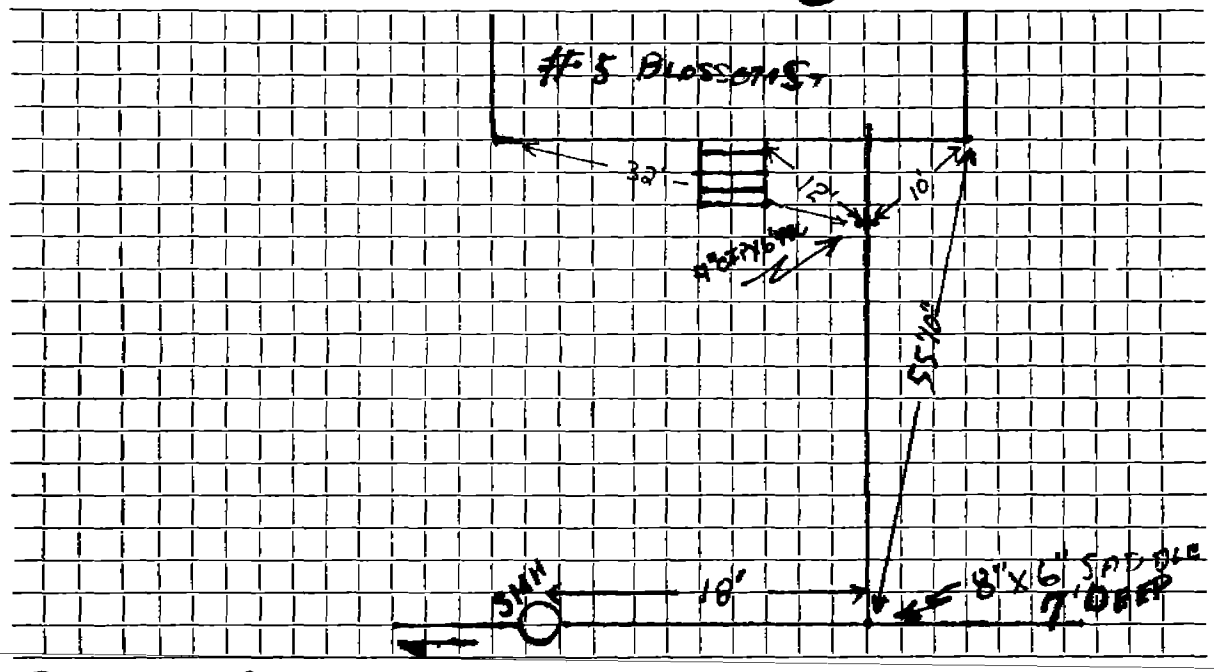

Connection made in BLOSSOM ST Street. Work completed 10-4-82

Remarks: