Name Joan Fennell **Service No.** 64

Address #11 BLOSSOMCREST RD.

Location

Kind of Pipe A.C. **Size** 6" **Size of Main** 8"

~~Repair~~ ~~Renewal~~ **New Service** Trebino #3175 **Location** FEB 13 1978

Date	Material	Amount	Total	Date		Amount
6/20/77	21' - 6" AC @	$10.00	$210.00	8-8-77	Deposit	210 00
8/11/77	59' - 6" ACP 6' - 4" CI					

H.B.M.10501

DATE _____

TOWN OF LEXINGTON — BOARD OF PUBLIC WORKS

SEWER DIVISION

Sketch of Service Here 11

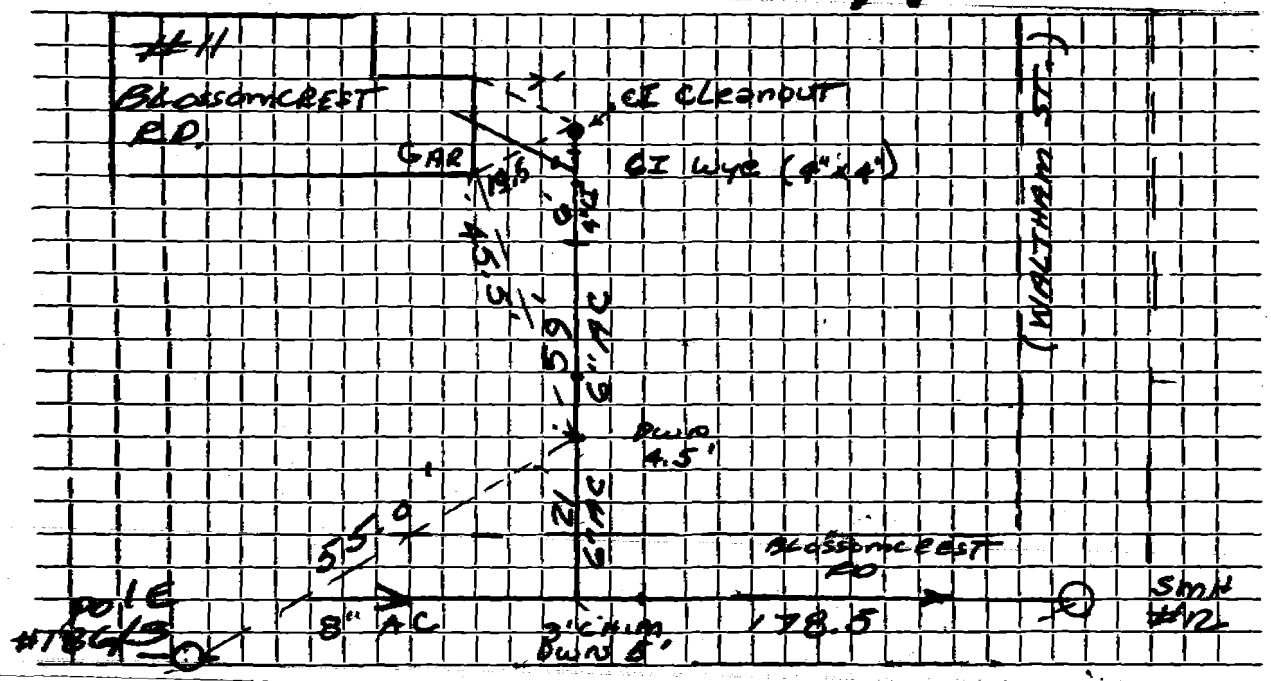

Connection made in . BLOSSOMCREST RD. ~~Street.~~ Work completed .....

Remarks: .....