Name Coby O'Brien

Service No. 66

Address #16 BLOSSOMCREST RD.

Location

Kind of Pipe AC

Size 6"

Size of Main 8"

Repair—Renewal—New Service Trebino #3178

Location

FEB 13 1978

Date	Material	Amount	Total	Date		Amount
6/21/77	28'-6" AC @	$10.00	$280	8-11-77	Deposit	280.00
9/13/77	53'-6" AC					
	10' 4" CI					

F.B.N.18502

DATE _____

TOWN OF LEXINGTON — BOARD OF PUBLIC WORKS

SEWER DIVISION

Sketch of Service Here 16

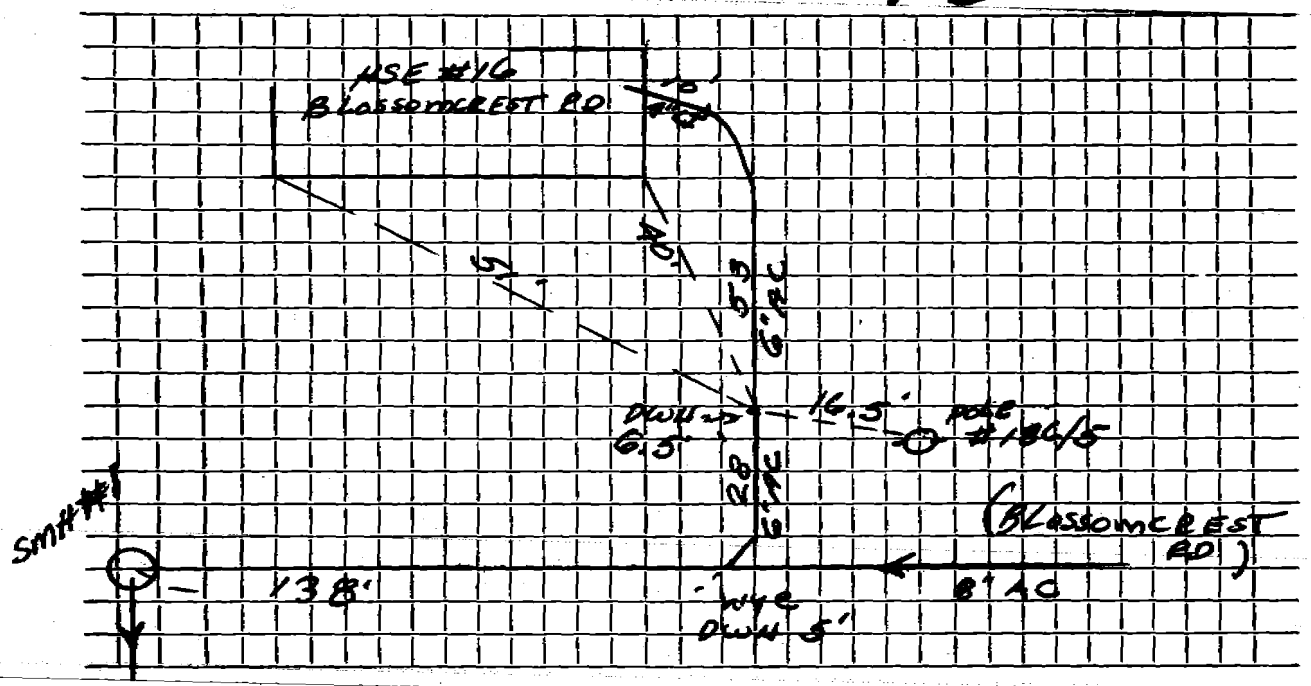

Connection made in ...BLOSSOMCREST RD... ~~Street.~~ Work completed .....

Remarks: .....

.....

.....