Name

Service No. 1503

Address 23 Blossomcrest RD

Location

Kind of Pipe PVC

Size 6"

Size of Main

Repair—Renewal—New Service J McLaughlin

Location

Date		Material	Amount	Total	Date		Amount
7/28/04	6'	Sch 40-4"					
	17'	6" PVC					
	1	6"-22½° bend					
	1	4X6 Fernco					
		PVC on Existing					
6/14/77	23'	A.C.					
9/18/89							

DATE _____

TOWN OF LEXINGTON — BOARD OF PUBLIC WORKS

SEWER DIVISION

Sketch of Service Here

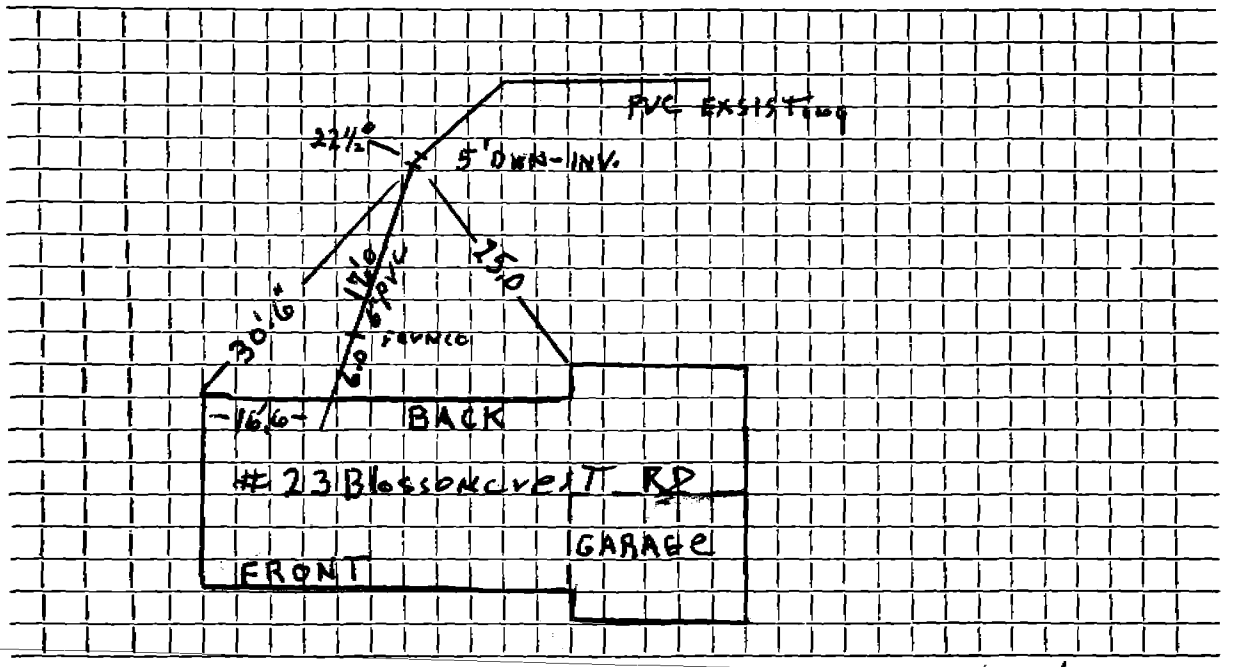

Connection made in ..... Street. Work completed 7/28/04

Remarks: J. McLaughlin

Name Jong Kim **Service No.**

Address 23 Blossomcrest Road

Location

Kind of Pipe PVC **Size** 6" **Size of Main** 8"

Repair—Renewal—New Service Suburbanite #505 **Location**

Date		Material	Amount		Total		Date			Amount	
6/14/77	23'	6" AC @ $10.00			230.	00	9/12/89		Paid	230	00
9/18/89	41.5'	6" Transite									

DATE 9/18/89

TOWN OF LEXINGTON — BOARD OF PUBLIC WORKS

SEWER DIVISION

Sketch of Service Here **23**

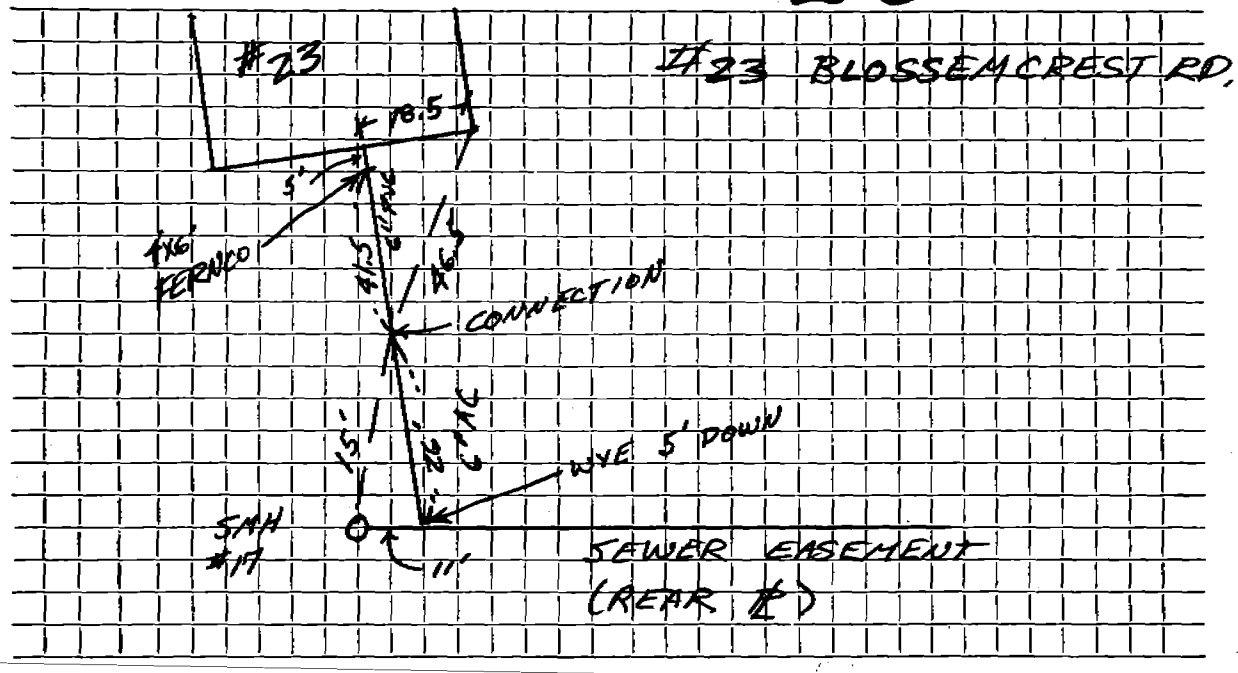

Connection made in SEWER EASEMENT Street. Work completed .....

Remarks: INSP. M. BILLIES CONNECTED TO 6" AC