Name Herbert R. Drury **Service No.** 61

Address #39 BLOSSOMCREST RD.

Location

Kind of Pipe AC **Size** 6" **Size of Main** 8"

Repair—Renewal—New Service Trebino #3021 **Location** FEB 13 1978

Date	Material	Amount	Total	Date		Amount
6/14/77	13' - 6" AC @	$10.00	$130.00	8-3-77	Deposit	130.00
8/24/77	70' - 6" ACP					
	10' - 4" CI					

H.B.M.18501

DATE

TOWN OF LEXINGTON — BOARD OF PUBLIC WORKS

SEWER DIVISION

Sketch of Service Here 39

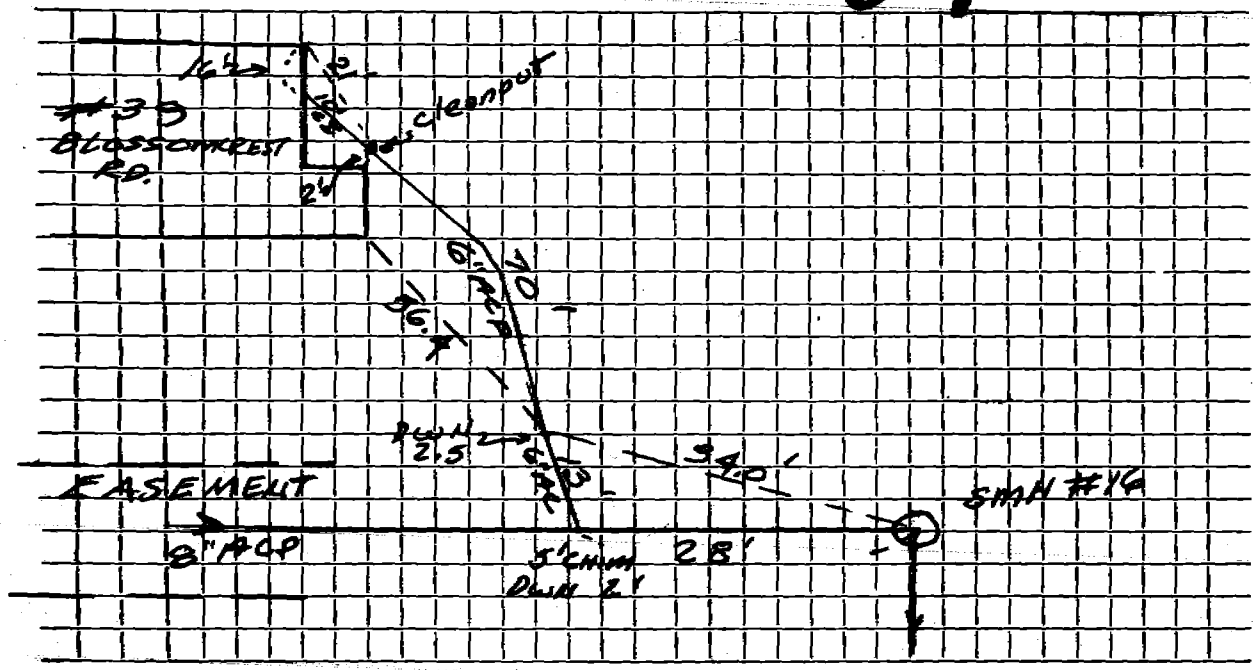

Connection made in ..... Street. Work completed .....

Remarks: .....