**Name** *Moore Homes* **Service No.**

**Address** *65 Bow Street*

**Location**

**Kind of Pipe** **Size** **Size of Main**

**[redacted]—New Service** *James McLaughlin #4205* **Location**

| Date | | Material | Amount | | Total | | Date | | | Amount | |
|---|---|---|---|---|---|---|---|---|---|---|---|
| *10/4/85* | *82'* | *6" PVC* | | | | | | | | | |
| | *8'* | *4" PVC* | | | | | | | | | |
| | *1* | *4" x 6" Fernco* | | | | | | | | | |
| | *1* | *45° Bend* | | | | | | | | | |
| | *1* | *6" Service Saddle* | | | | | | | | | |

DATE _____

TOWN OF LEXINGTON — BOARD OF PUBLIC WORKS

## SEWER DIVISION

Sketch of Service Here 65

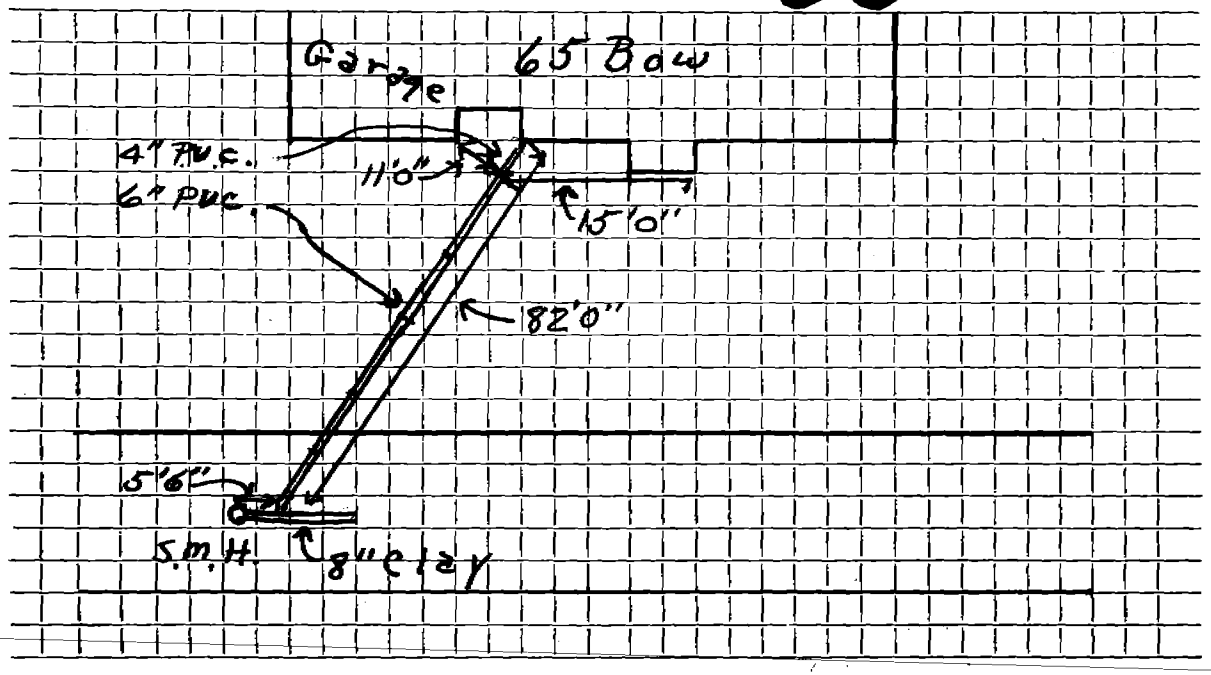


Connection made in ..... Street. Work completed .....

Remarks: .....

.....

.....