Name **Service No.**

Address 17 Bowker Street

Location

Kind of Pipe **Size** **Size of Main**

~~Repair~~ ~~Renewal~~ **New Service** **Location**

Date		Material	Amount	Total	Date		Amoun
7-19-60		Labor	41 14				
		10% O.H.	4 11	45 25			
	27'	6" Transite pipe@.78		21.06			
	2	Hrs. Town shovel@6.50		13 00			
	1	Hr. Trucking@3.00		3 00			
	1	Hr. Allis Chalmers dozer@3.00		3 00			
		BILL WHEN CONNECTED		85 31			

H.B.M.18501

DATE _____

TOWN OF LEXINGTON — BOARD OF PUBLIC WORKS

SEWER DIVISION
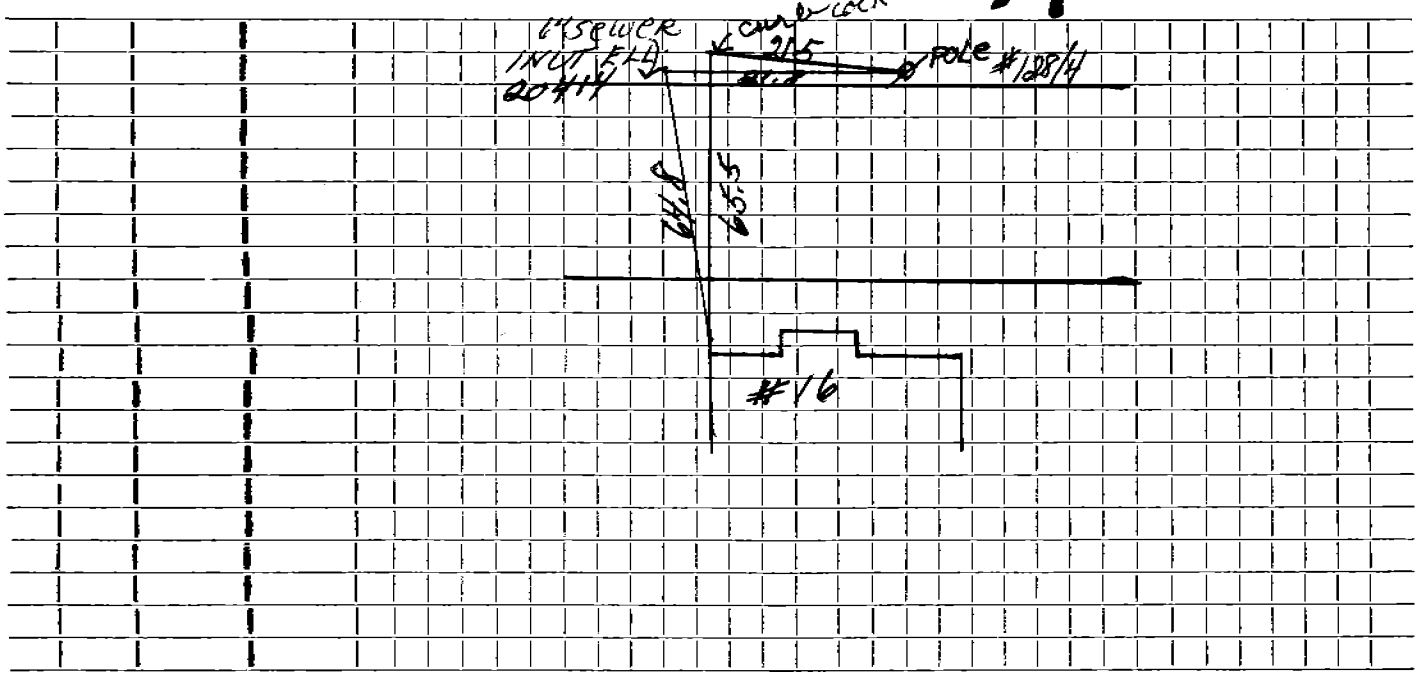
Sketch of Service Here **17**