Name Donald Banks

Service No. 93

Address 16 Brandon Street

Lexington, Mass.

Location

Kind of Pipe

Size

Size of Main

~~Repair~~ ~~Renewal~~ New Service

Location

Date	Material	Amount	Total	Date		Amount
Aug.24, '48	Labor	31 33	31 33	Aug 10 '48	Deposited	100 00
	10% Overhead		3 13	Dec 31 '48	Refunded	29 60
	42'-6" Sewer Pipe @ .26		10 92			70 40
	Joint Compound		2 52			
	3 hrs. Littlefield Shovel		21 00			
	2 hrs. Trucking	1 50	1 50			
			70 40			
	Labor					

HP-7919

TOWN OF LEXINGTON—DEPT. OF PUBLIC WORKS

SEWER DIVISION

DATE ..... NO. .....

The undersigned applies for the construction of a particular sewer connecting No. ..... Street and hereby agrees to comply with the Rules and Regulations governing the construction and use of Particular Sewers, as now or at any future time established by the Board of Selectmen.

Am't of estimate $. . . . . .

Am't Paid $. . . . . .

..... Owner

Sketch of Service Here

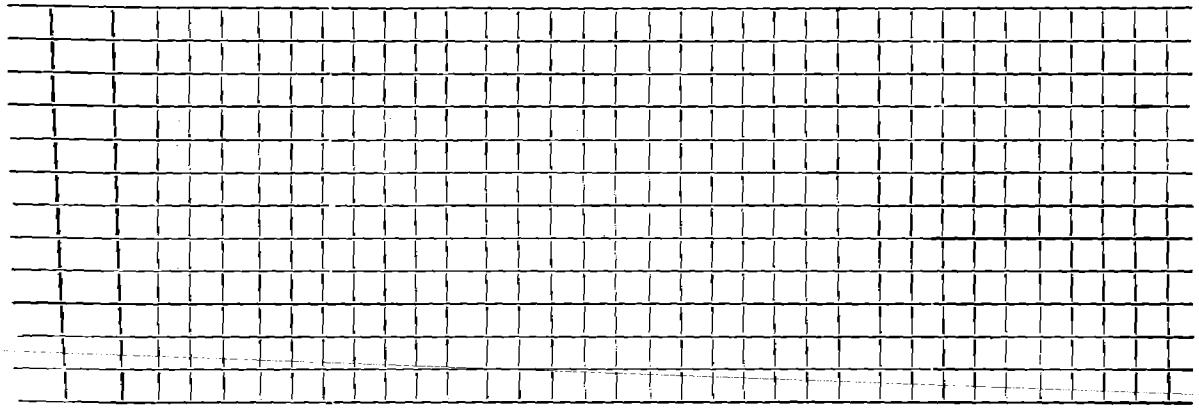

Connection made in ..... Street. Work completed ..... 19..

Remarks: