Name J. Neil Morrissey **Service No.** 90

Address 25 Brandon Street

Location

Kind of Pipe **Size** **Size of Main**

Repair—Renewal—New Service COM. 8-30-54 **Location**

Date	Material	Amount	Total	Date		Amount
6/28/54	Labor	55 06		6-11-54	Deposited	125 00
	10% Overhead	5 51	60 57	8-30-54	Refunded	(24 93)
	50'-6" Sewer Pipe @.30		15 00			100 07
	Joint Compound		3 00			
	4 Hrs. Town Shovel @ 5.00		20 00			
	2 Hrs. Trucking. .75		1 50			
			100 07			
	Labor					

HP-9694

TOWN OF LEXINGTON—DEPT. OF PUBLIC WORKS
SEWER DIVISION

DATE..... NO.....

The undersigned applies for the construction of a particular sewer connecting No..... Street and hereby agrees to comply with the Rules and Regulations governing the construction and use of Particular Sewers, as now or at any future time established by the Board of Selectmen.

Am't of estimate $.....

Am't Paid $.....

..... Owner

Sketch of Service Here

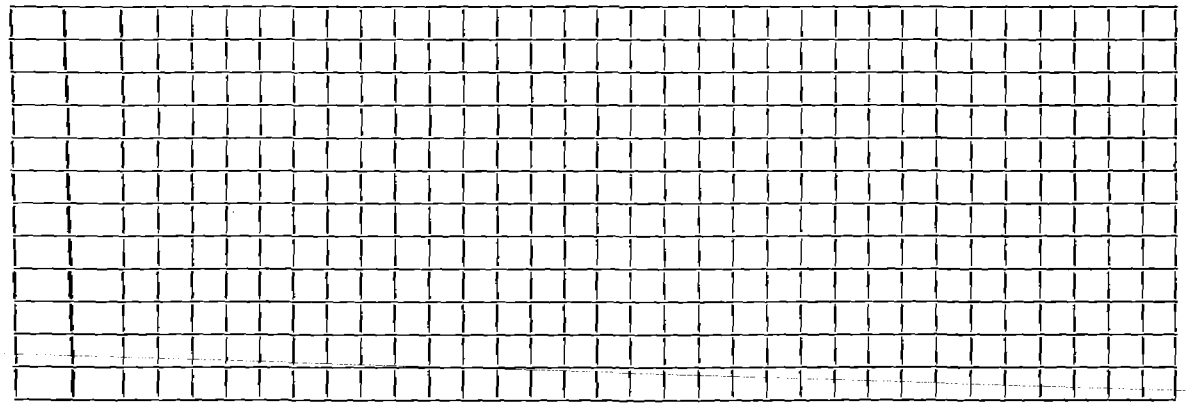

Connection made in..... Street. Work completed.....19..

Remarks: