Name Joseph E. Trodella **Service No.** 189

Address 10 Brent Road

Location

Kind of Pipe W.O. # **Size** 6" A.C **Size of Main** 8"

Repair—Renewal—New Service ✓ DeFlice Bros. # 2437 **Location** FEB 10 1975

Date	Material	Amount	Total	Date		Amount
11/26/73	21' of 6" A.C.@9.00	$189.00		11-28-73	Deposit	189.00
11-26-73	36'-6" ACP					
	10'-4" CI					

H.B.M.18501

DATE.....

TOWN OF LEXINGTON — BOARD OF PUBLIC WORKS

SEWER DIVISION

Sketch of Service Here 10

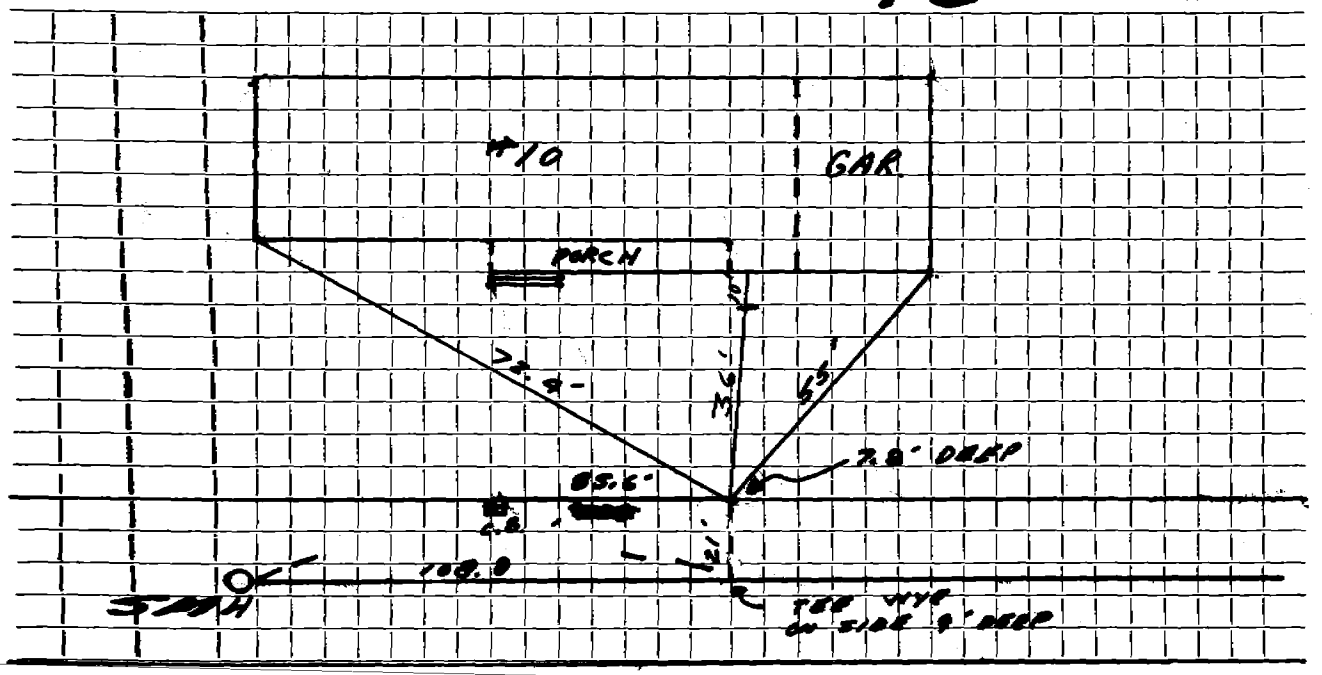

Connection made in ..... Street. Work completed .....

Remarks: .....

.....

.....