Name Edward A. Petronio **Service No.** 24 (75)

Address 15 Brent Road

Location

Kind of Pipe **Size** 6" A.C **Size of Main** 8"

Repair—Renewal—New Service Suburbanite Cesspool Service #2623 **Location** AUG 16 1976

Date		Material	Amount	Total	Date		Amount
11/26/73		23' 6" A.C. @ 9.00	$207.00		4-10-75	Deposit	207.00
4/29/75	58'	6" Transite Pipe					
	26'	4" Cast Iron Pipe					

.B.M.18501

DATE

TOWN OF LEXINGTON — BOARD OF PUBLIC WORKS

SEWER DIVISION

Sketch of Service Here 15

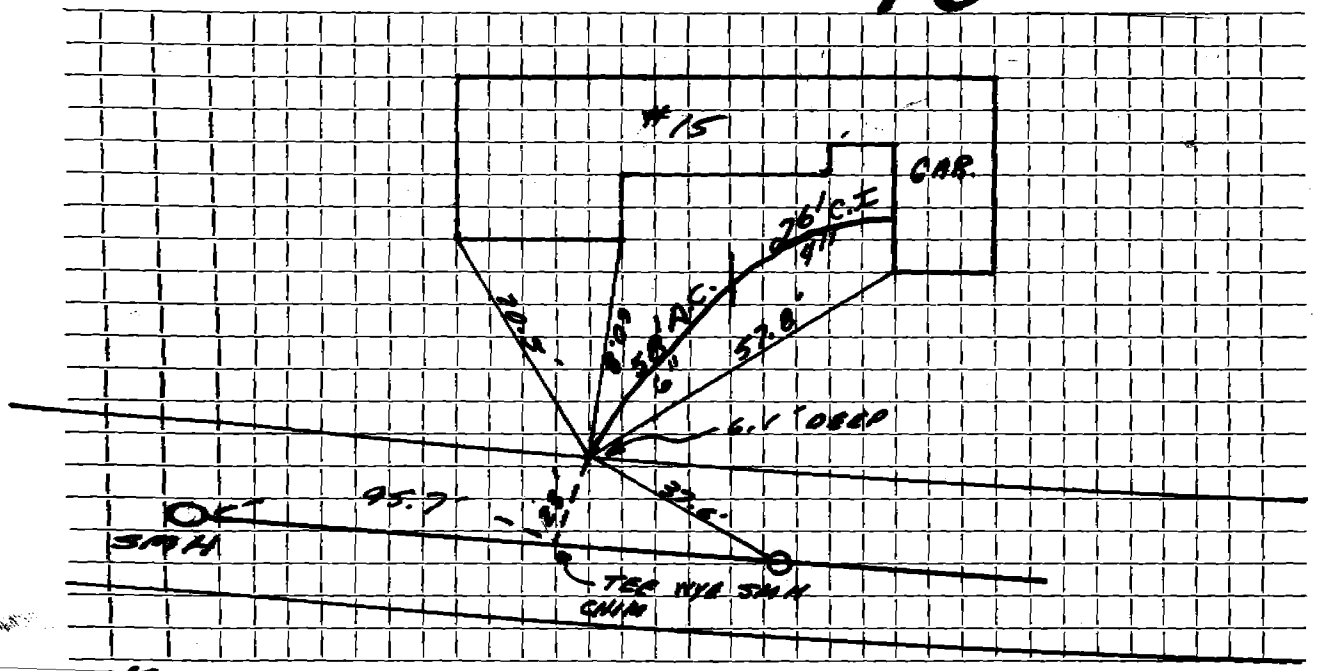

Connection made in #15 BRENT Rd. Street. Work completed 4/29/25

Remarks: