Name W. A. Melbye **Service No.** 181 ('65)

Address 31 Bridge Street

Location

Kind of Pipe **Size** **Size of Main**

Repair—Renewal—New Service T.D.Sullivan Permit #A27 **Location** JUL 25 1966

Date		Material	Amount		Total		Date			Amount	
1965	20'	Transite pipe @ 7.00	$140	00			10-4-65		Deposit	140	00
6/20/66	98'	6" Transite pipe									

H.B.W.18501

DATE _____

TOWN OF LEXINGTON — BOARD OF PUBLIC WORKS

SEWER DIVISION

Sketch of Service Here 31

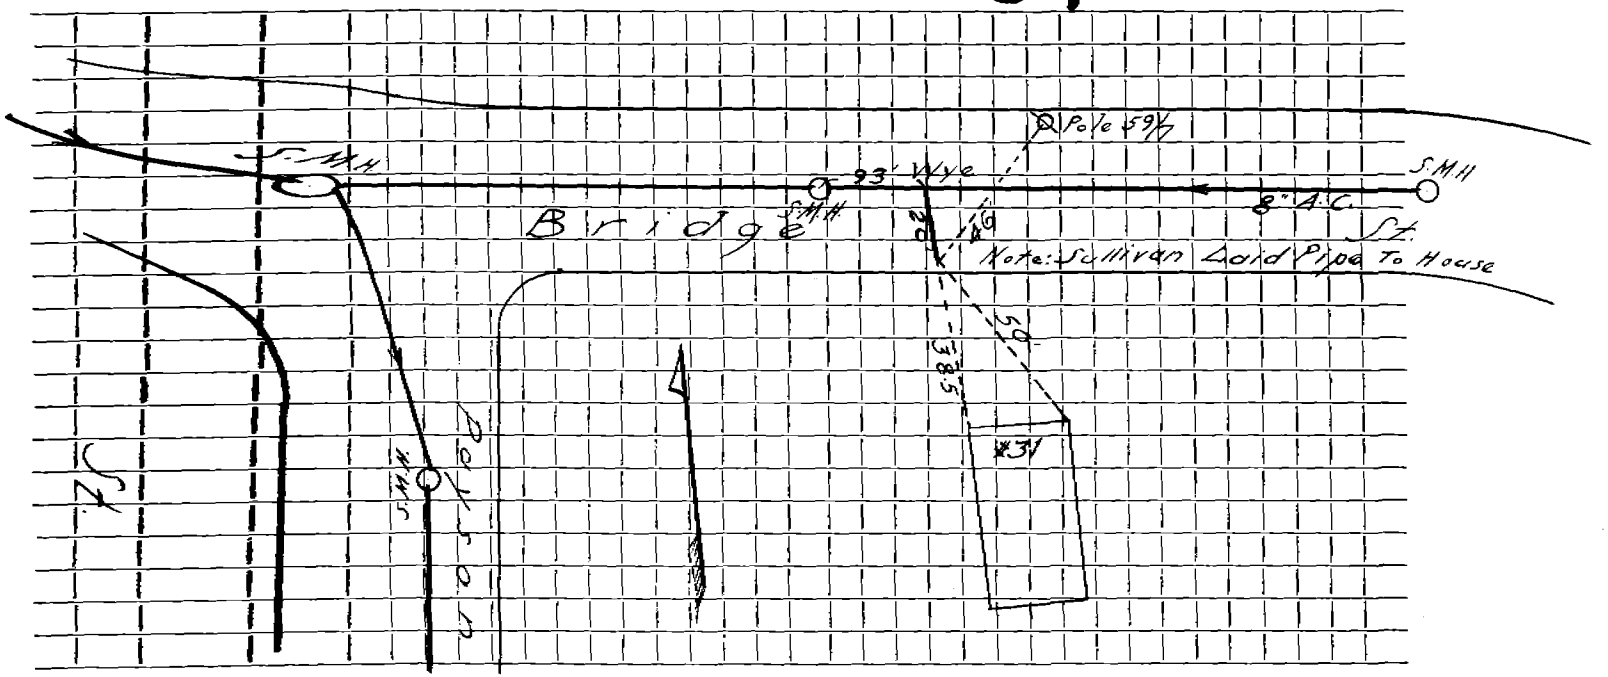

nnection made in . . . . . Street. Work completed . . . . . .

narks: . . . . . .

. . . . . .

. . . . . .