Name William D. Mark **Service No.** 50

Address 35 Bridge Street

Location

Kind of Pipe **Size** **Size of Main**

Repair—Renewal—New Service Trebino #2287 **Location** NOV 19 1973

Date		Material	Amount	Total	Date			Amount
~~1965~~	~~25'~~	~~Transite pipe~~ @ 7.00		$175 00	6-1-73		Deposit	175 00
6/10/73	25'	6" Transite pipe						
	10'	4" Cast Iron pipe				1965		
9-29-	78	Repair				25'	6" Transite	
	1	6"X12" Repair Clamp						
					12-1-	78	S.B. Roots 27 ½' To 48'	

H.B.M.18501

DATE _____

TOWN OF LEXINGTON — BOARD OF PUBLIC WORKS

SEWER DIVISION

Sketch of Service Here 35

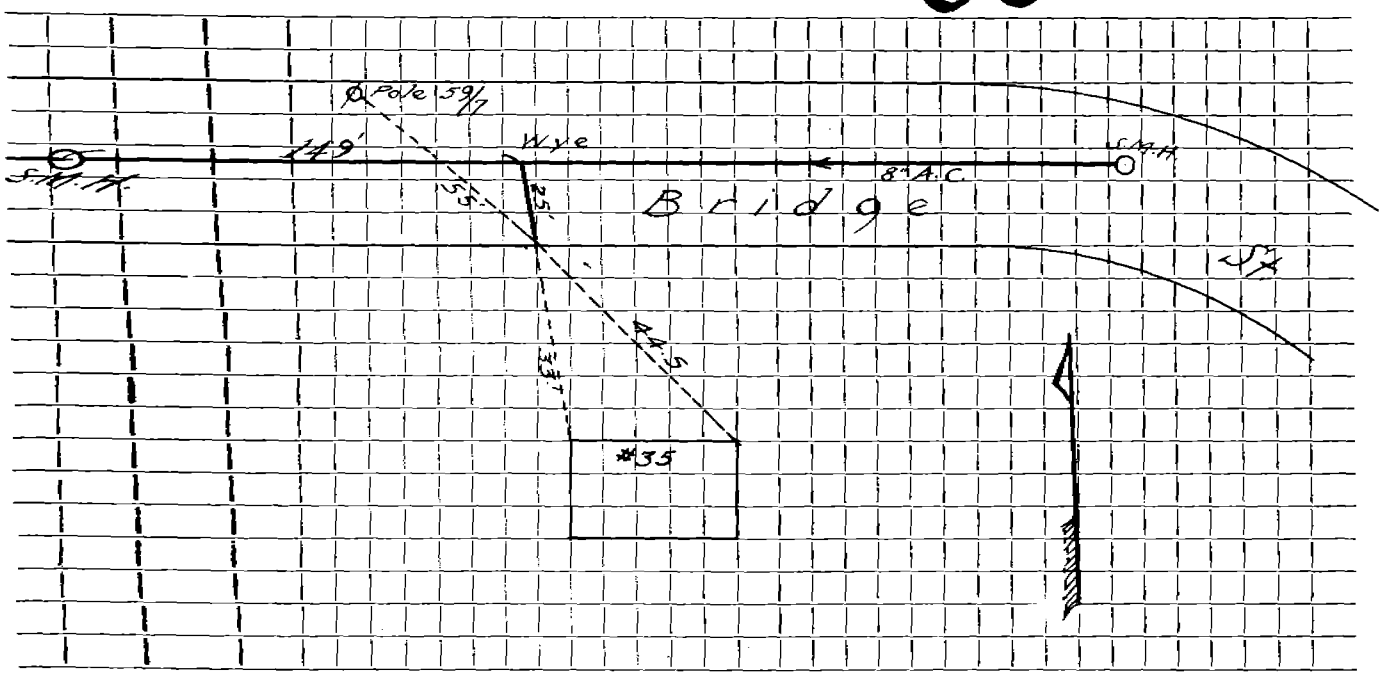

nection made in . . . . . Street. Work completed . . . . . .

narks: . . . . . .

. . . . . .

. . . . . .