Name Stratvern Realty **Service No.** 122

Address 87 Bridge Street # 87 Bridge - Lot 104

Lot 104 **Location**

Kind of Pipe **Size** **Size of Main**

Repair—Renewal—New Service Kirkland #811 **Location**

Date		Material	Amount		Total		Date			Amount	
~~Jul '66~~	~~25'~~	~~6" Transite pipe~~ @5.00			125.00		9-28-67		Deposit	125	00
10-19-67	30'	6" Transite pipe									
	10'	4" Cast Iron pipe					7-	-66			
								25'	6" Transite		

H.B.M.18501

DATE _____

TOWN OF LEXINGTON — BOARD OF PUBLIC WORKS

SEWER DIVISION

Sketch of Service Here 87

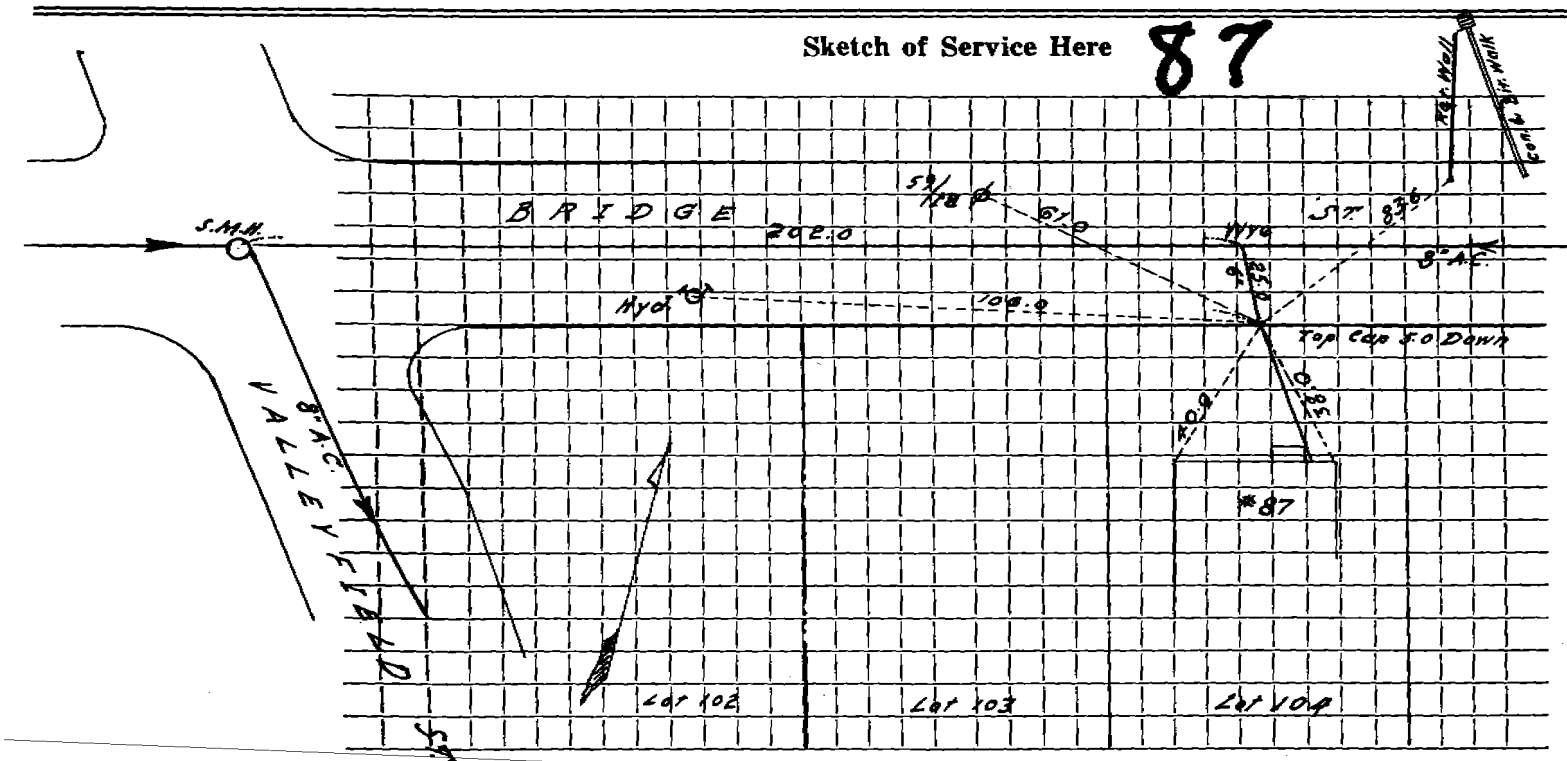

Connection made in ..... Street. Work completed .....

Remarks: .....

.....

.....