Name Robert C. Currie **Service No.** 15

Address 6 Brookside Avenue Lot 135B

Lot 135-B **Location**

Kind of Pipe **Size** **Size of Main**

Repair—Renewal—New Service Lexington Sewerage #971 **Location** MAY 13 1968

Date		Material	Amount		Total		Date			Amount	
~~1965~~	~~31'~~	~~Transite pipe~~ @ 7.00			$217	00	4-5-68		Deposit	217	00
4-11-68	137'	6" Transite pipe						1965			
								31'	Transite		

R.B.N.18501

DATE_____

TOWN OF LEXINGTON — BOARD OF PUBLIC WORKS

SEWER DIVISION

Sketch of Service Here 6

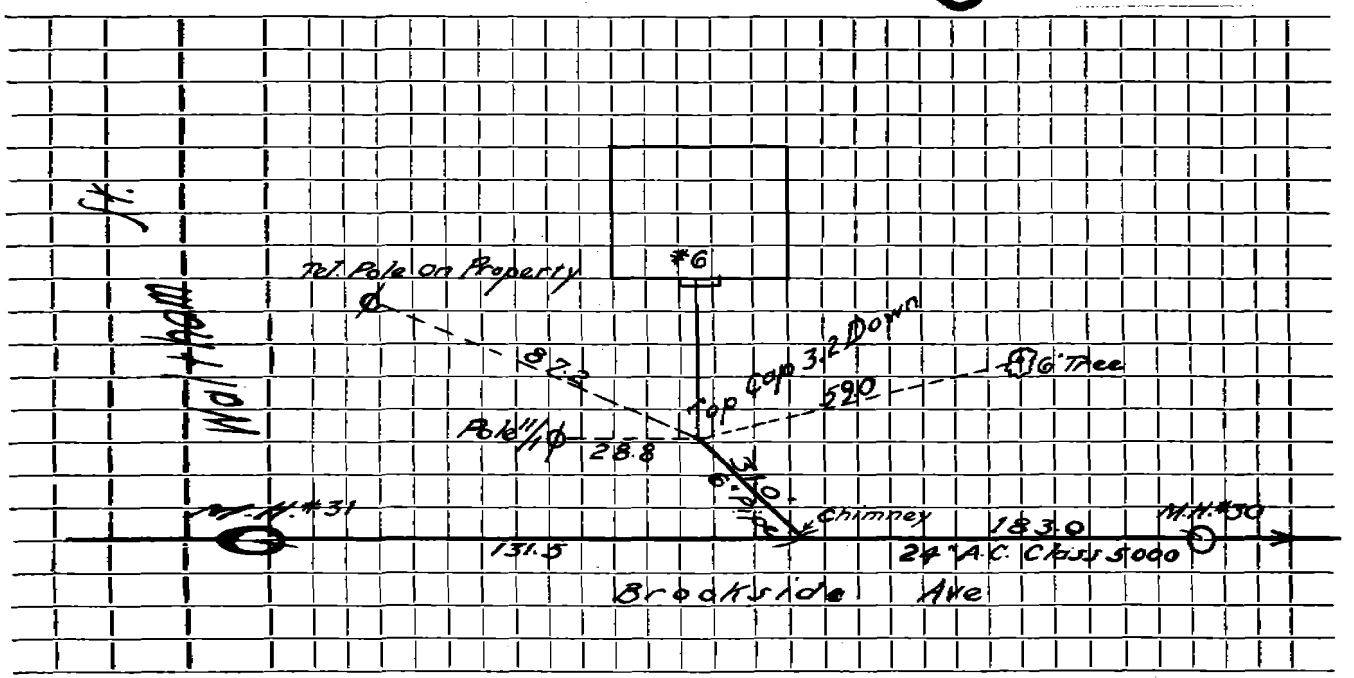

nection made in . . . . . Street. Work completed . . . . . .

narks: . . . . . .

. . . . . .

. . . . . .