Name 7

Service No.

Address 7 Brookside Avenue

Lot #146

Location

Kind of Pipe

Size

Size of Main

Repair—Renewal—New Service

Location

Date	Material	Amount	Total	Date		Amount

N.B.M.18501

DATE_____

TOWN OF LEXINGTON — BOARD OF PUBLIC WORKS

SEWER DIVISION

Sketch of Service Here

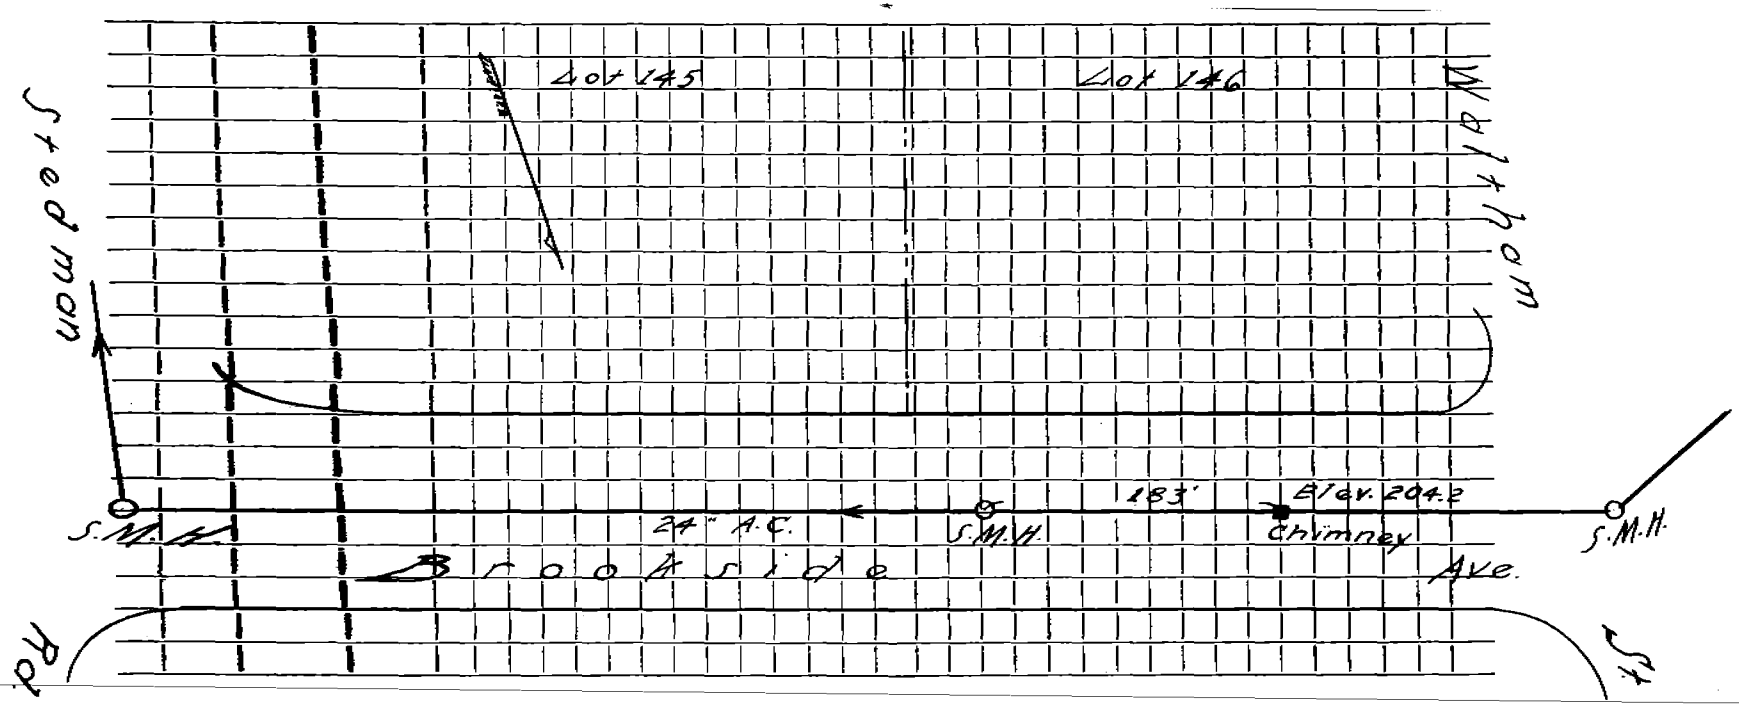

onnection made in . . . . . Street. Work completed . . . . . .

emarks: . . . . . .

. . . . . .

. . . . . .