Name Anthony Bottolini Service No. 49

Address # 9 BROWN RD

Location

Kind of Pipe Size 6"AC Size of Main 8"AC

~~Repair~~ ~~Renewal~~ New Service Eagle #3172 Location AUG 29 1977

Date		Material	Amount		Total		Date			Amount	
~~4/20/72~~		~~20.0' 6"AC @ $9.00~~	$180.	00			7/15/77		Deposit	180.	00
7/29/77	108'	6" transite									
	10'	4" C.I.					11-20-72				
								20'	6" A.C. Pipe		

P.B.K.18501

DATE _____

TOWN OF LEXINGTON — BOARD OF PUBLIC WORKS

SEWER DIVISION

BROWN RD

Sketch of Service Here 9

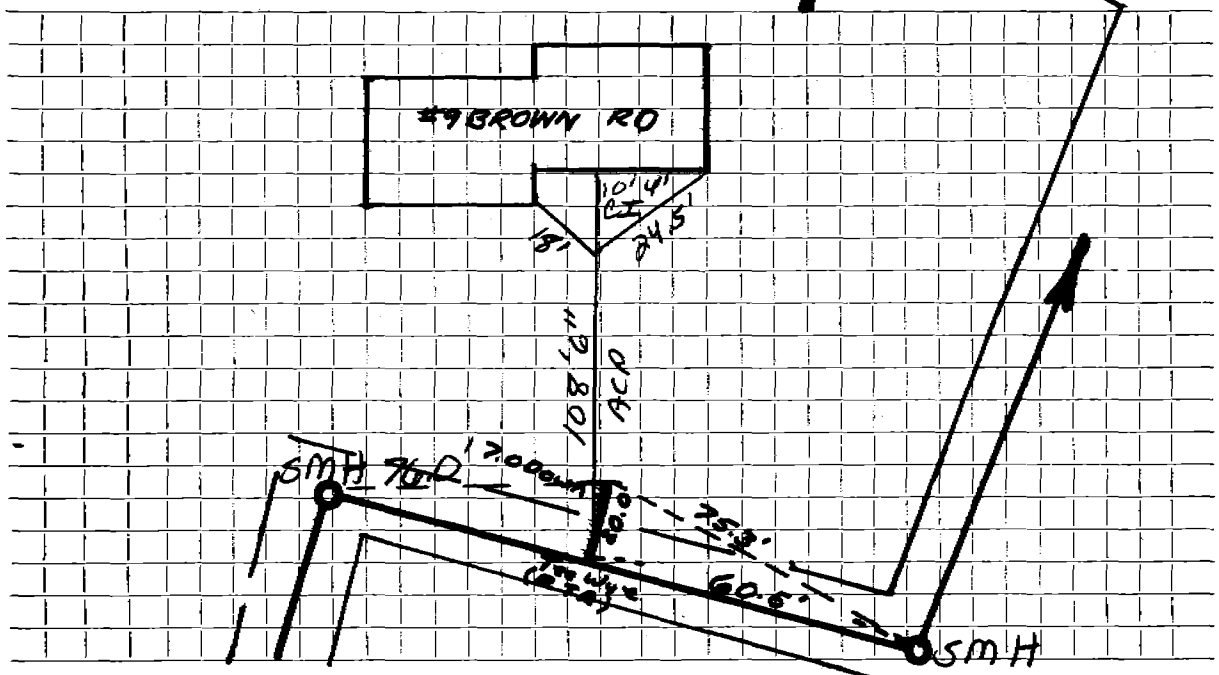

Connection made in ..... Street. Work completed .....

Remarks: .....

.....

.....