Name Peter J. Macolka **Service No.** 11

Address 38 Buckman Drive

Location

Kind of Pipe **Size** **Size of Main**

Repair—Renewal—New Service Craftsman #1824 **Location** JUL 26 1971

Date		Material	Amount		Total		Date			Amount	
1965	29'	Transite pipe @7.00			203	00	3-3-71		Deposit	203	00
		installed by contractor									
4/5/71	33'	6" Transite pipe									
	10'	4" Cast Iron pipe									

H.B.M.18501

DATE _____

TOWN OF LEXINGTON — BOARD OF PUBLIC WORKS

SEWER DIVISION

Sketch of Service Here 38

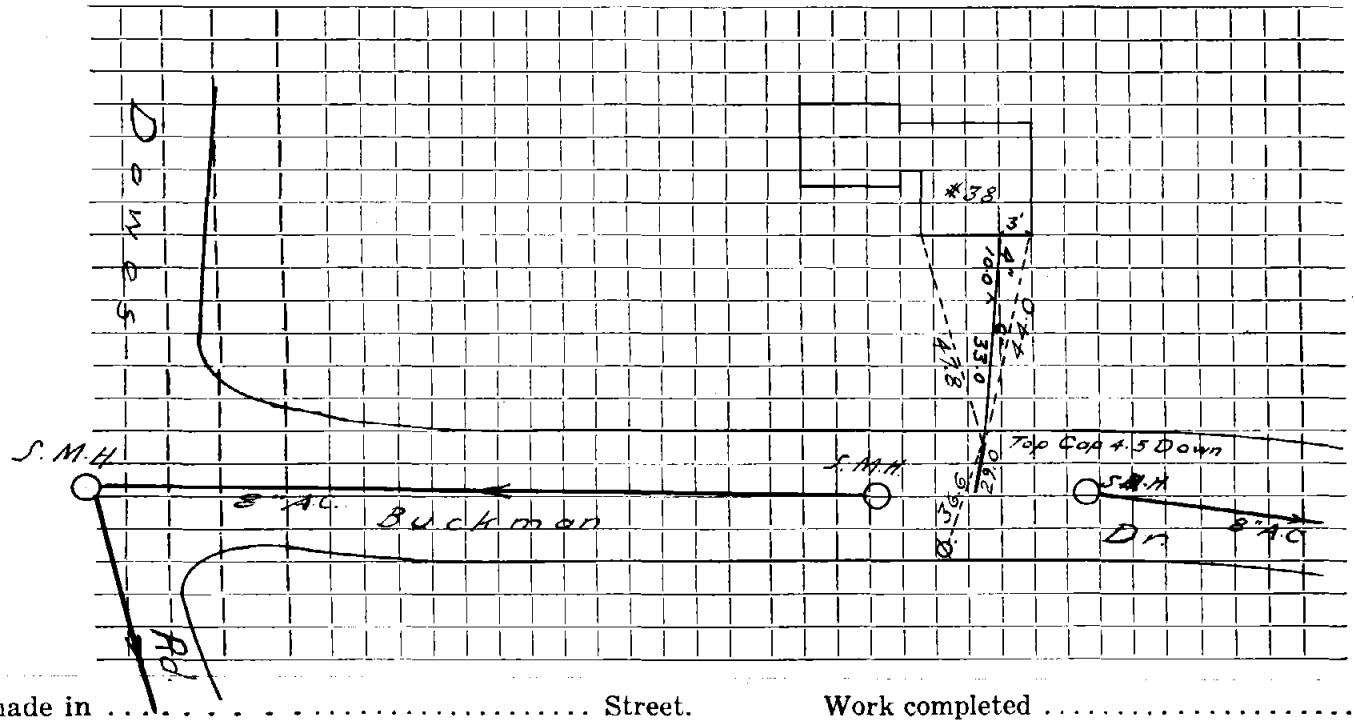

Connection made in ..... Street. Work completed .....

Remarks: .....

.....

.....