Name Charles W. Little **Service No.** 126

Address 42 Buckman Drive

Location

Kind of Pipe Lexington Landscape Permit #429 **Size** **Size of Main**

Repair—Renewal—New Service **Location** SEP 27 1965

Date		Material	Amount		Total		Date			Amount	
1965	30'	Transite pipe @7.00			210	00	8-9-65		Deposit	210	00
		installed by contractor									
1965	37'	6" Transite pipe									

H.B.M.18501

DATE _____

TOWN OF LEXINGTON — BOARD OF PUBLIC WORKS

SEWER DIVISION

Sketch of Service Here 42

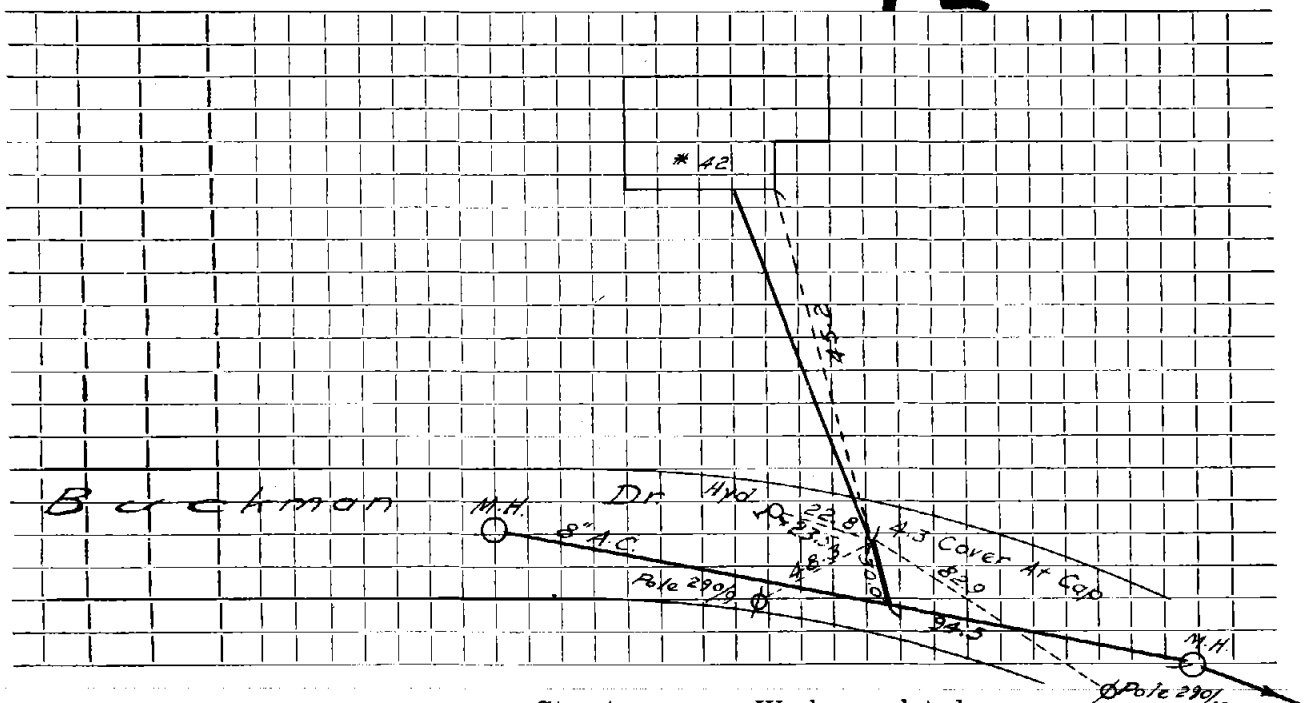

Connection made in ..... Street. Work completed .....

Remarks: .....

.....

.....