Name Alan W. Ham **Service No.** 114

Address 79 Buckman Drive

Location

Kind of Pipe **Size** **Size of Main**

Repair—Renewal—New Service Sibley #774 **Location** Comm 10-30-67

Date		Material	Amount		Total		Date			Amount	
~~1965~~	~~25½'~~	~~Transite pipe~~ @7.00			178	50	9-14-67		Deposit	178	50
		installed by contractor									
10-3-67	65'	6" Transite pipe						1965			
								25.6'	6" Transite		

H.B.M.18501

DATE _____

TOWN OF LEXINGTON — BOARD OF PUBLIC WORKS

SEWER DIVISION

Sketch of Service Here 79

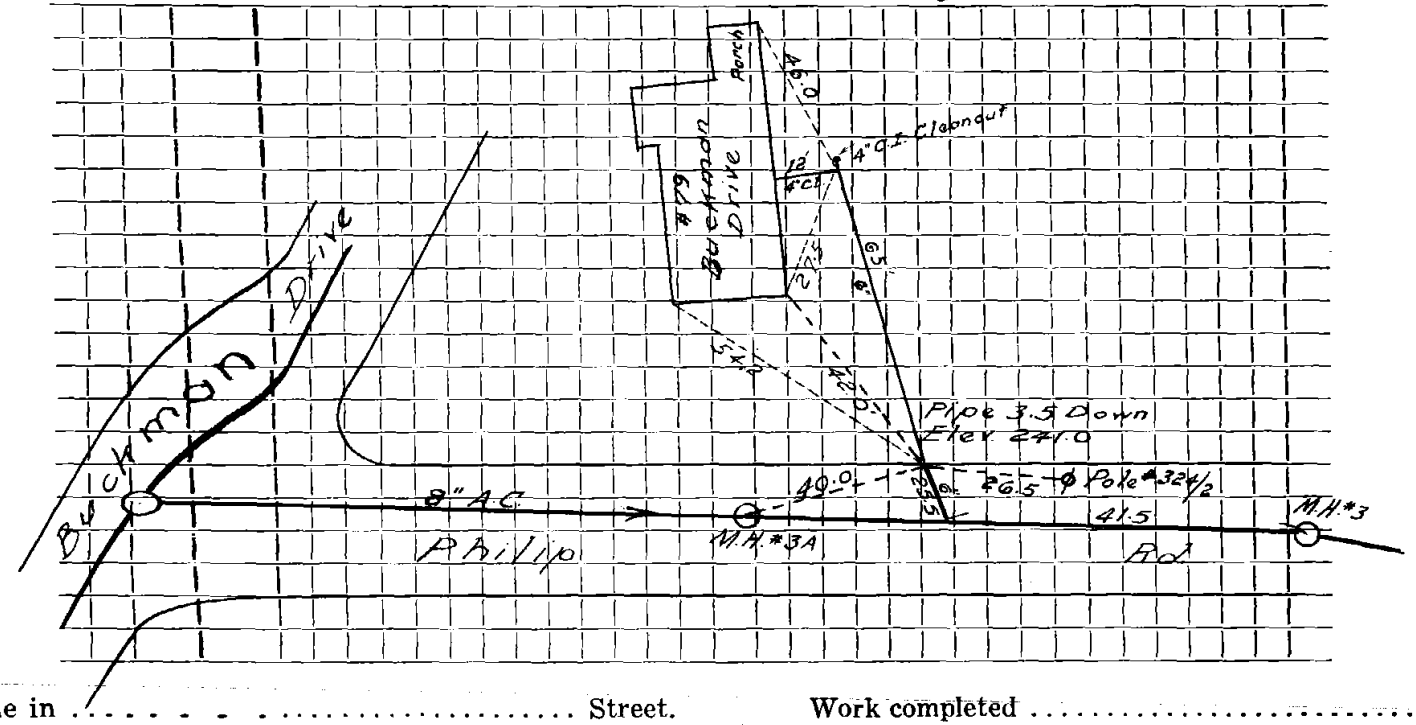

Connection made in ..... Street. Work completed .....

Remarks: .....

.....

.....