Name Marissa Liggiero **Service No.**

Address 116 Burlington Street

Location

Kind of Pipe SDR 35 PVC **Size** 6" **Size of Main**

Repair—Renewal—New Service **Location**

Date	Material	Amount	Total	Date		Amount
6/5/18	22° Bends	2				
	6" Fernco	1				

DATE 6/5/18

TOWN OF LEXINGTON — BOARD OF PUBLIC WORKS

SEWER DIVISION

Sketch of Service Here

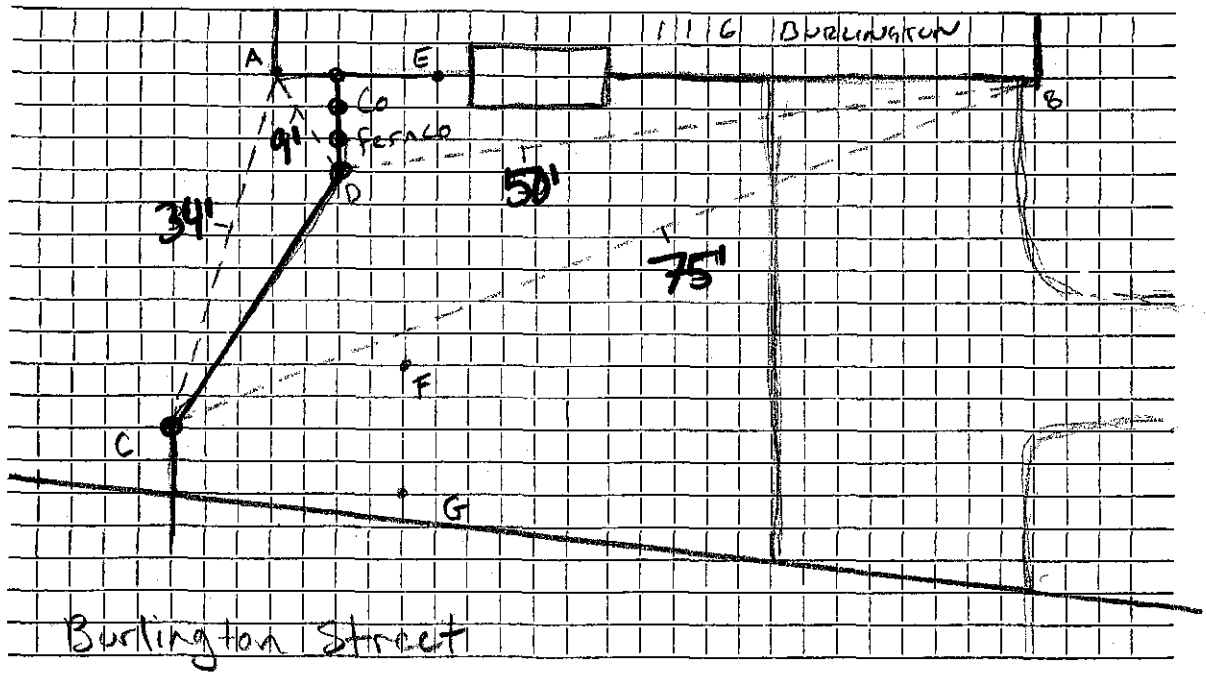

AD = 9'
AC = 34'
BD = 50'
BC = 75'

Connection made in ...Burlington..... Street. Work completed .....

Remarks: ...D. + C. are 22° Bends.....6" ferrco.....