Name Francis P. Carney **Service No.** 79

Address 126 Burlington Street Lot 5H

Location

Kind of Pipe **Size** **Size of Main**

Repair—Renewal—New Service Suburbanite #1185 **Location** JAN 27 1969

Date		Material	Amount	Total	Date			Amount
~~1965~~	~~11'~~	~~6" Transite pipe~~ @6.00		66.00	9-4-68		Deposit	66 00
9-9-68	49'	6" Transite pipe						
	23'	4" Cast Iron pipe				1965		
						11'	6" Transite	

H.B.M.18501

DATE _____

TOWN OF LEXINGTON — BOARD OF PUBLIC WORKS

SEWER DIVISION

Sketch of Service Here 126

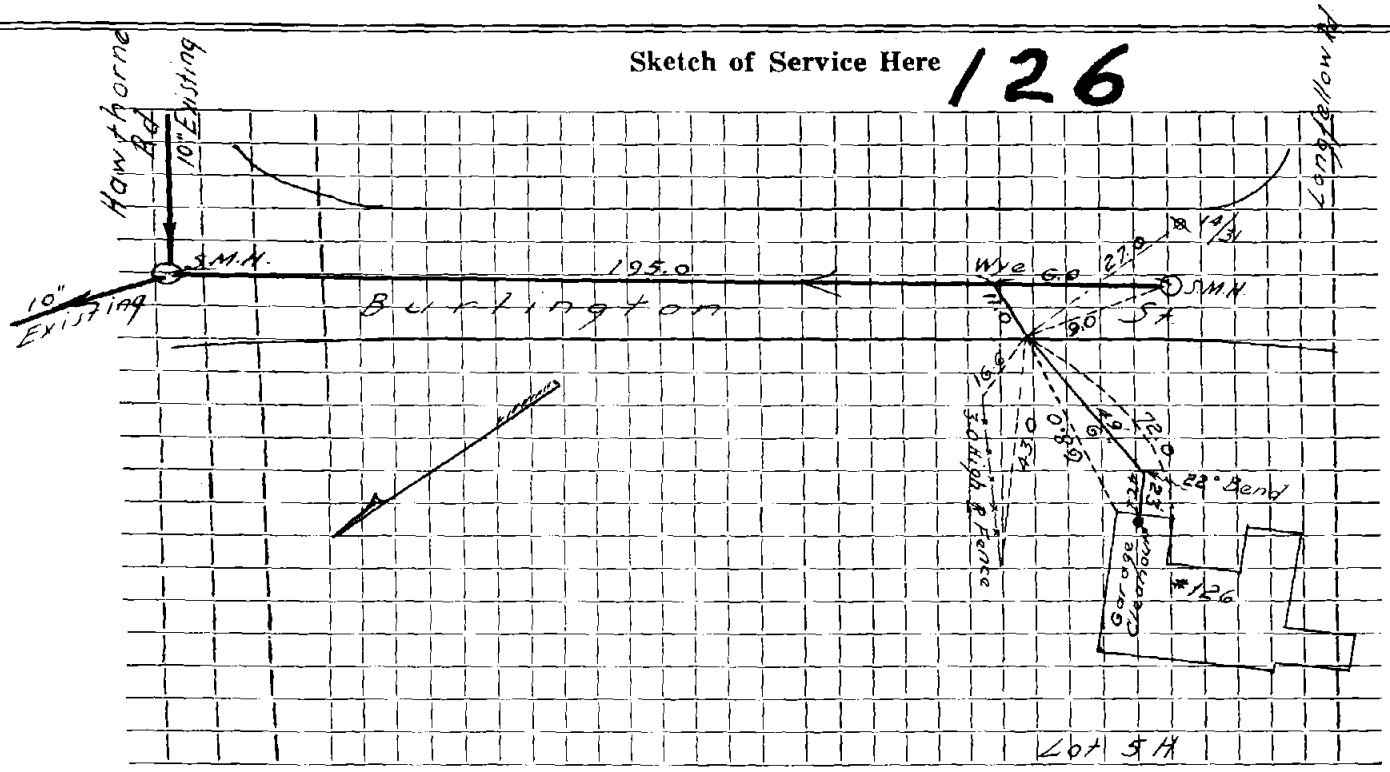

Connection made in ..... Street. Work completed .....

Remarks: .....

.....

.....