Name **Service No.**

Address 180 Burlington St

Location

Kind of Pipe SDR35 PVC **Size** 6" **Size of Main**

Repair—Renewal—New Service **Location**

Date	Material	Amount	Total	Date		Amount
6/8/2023	4"x6" Reducer	1				
	6" clean out	1				
	6" 45 Bend	1				
	6" clean out	1				
	6"x6" wye	1				
	4" under footing	1				
	6" 45 bend	1				

DATE 6/8/2023

TOWN OF LEXINGTON — BOARD OF PUBLIC WORKS

SEWER DIVISION

Sketch of Service Here

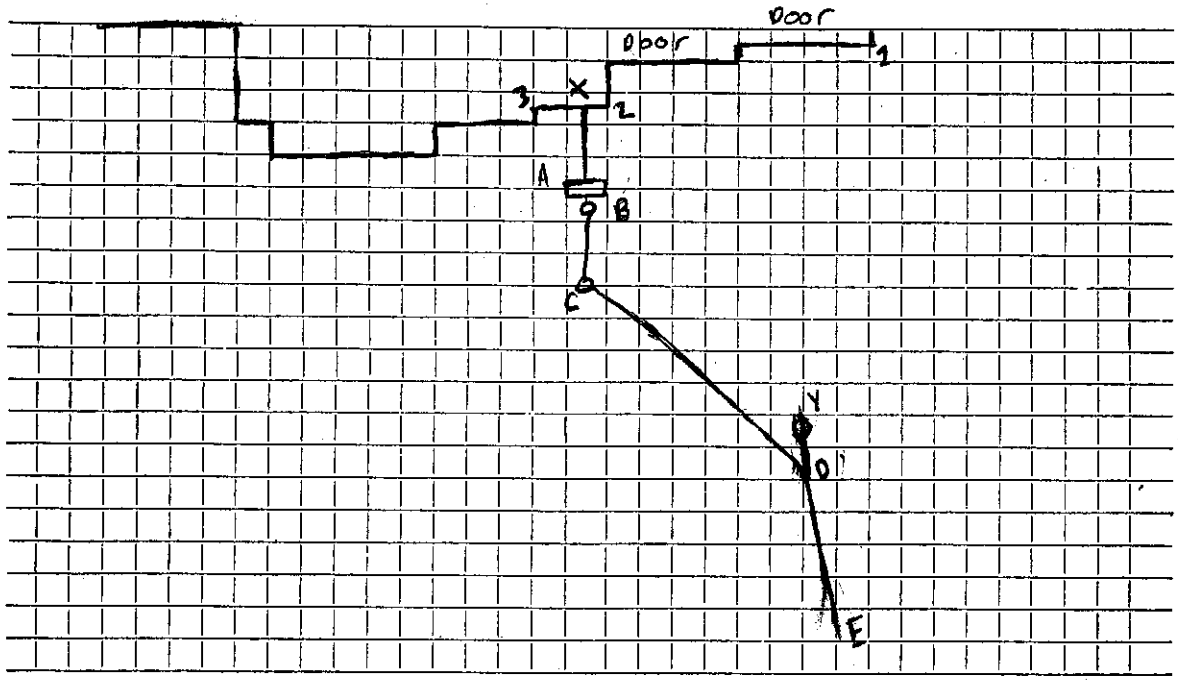

Sewer ties

2-A = 7.4'
3-A = 7.6'
2-B = 9.2'
3-B = 9'
2-C = 15.1'
3-C = 14.7'
1-D = 40.5'
2-D = 44.7'
1-E = 66.8'
2-E = 68.8
1-Y = 37.8'
2-Y = 42.4'
2-X = 2.6'

Descriptions

1 - outside CNR Garage
2 - outside CNR House
3 - Jog
A - 4"x6" reducer (no hub)
B - 6" clean out
C - 6" 45 bend
D - 6" clean out (inv = 90.87)
E - 6"x6" wye (no hub) (inv = 87.13)
X - 4" under footing (elev = 92.51)
Y - 6" 45 bend

Connection made in ..... Street. Work completed .....

Remarks: Installed by Frank Delueia & Son inc.