Name James Bradley **Service No.** 21

Address 11 Burroughs Road
Lot 90 **Location**

Kind of Pipe **Size** **Size of Main**

Repair—Renewal—New Service Lexington Sewerage #1837 **Location** JUL 26 1971

Date		Material	Amount	Total	Date			Amount
~~Sep'68~~	~~25½'~~	~~6" Transite pipe~~	~~@8.00~~	~~204.00~~	4-21-71		Deposit	204 00
4/30/71	131'	6" Transite pipe						
	10'	4" Cast Iron pipe			8-	-68		
						25.6	6" Transite	

H.B.M.18501

DATE _____

TOWN OF LEXINGTON — BOARD OF PUBLIC WORKS

SEWER DIVISION

Sketch of Service Here

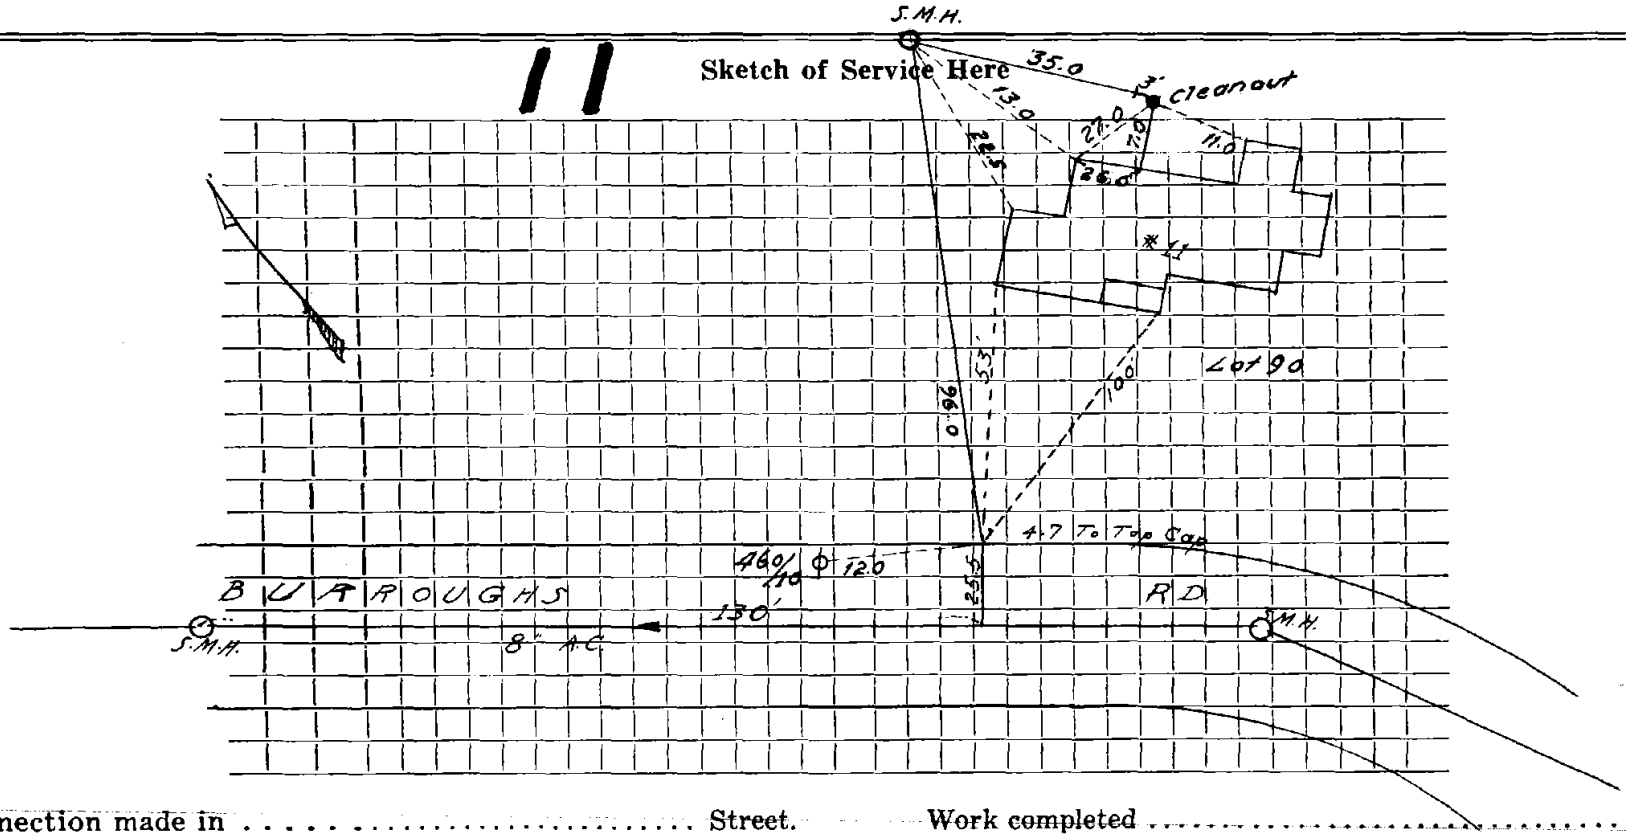

Connection made in ..... Street. Work completed .....

Remarks: .....

.....

.....

[redacted]