Name Ralph Callazzo **Service No.** 120

Address 20 Burroughs Road

Lot 76 **Location**

Kind of Pipe **Size** **Size of Main**

Repair—Renewal—New Service Suburbanite #1261 **Location** JAN 27 1969

Date		Material	Amount	Total	Date			Amount
~~Sep'68~~	~~31'~~	~~6" Transite pipe~~	~~@8.00~~	~~248.00~~	~~11-21-68~~		~~Deposit~~	~~248.00~~
11-21-68	66'	6" Transite pipe						
	18½'	4" Cast Iron pipe			9-	-68		
						31'	6" Transite	

DATE _____

TOWN OF LEXINGTON — BOARD OF PUBLIC WORKS

SEWER DIVISION

Sketch of Service Here 20

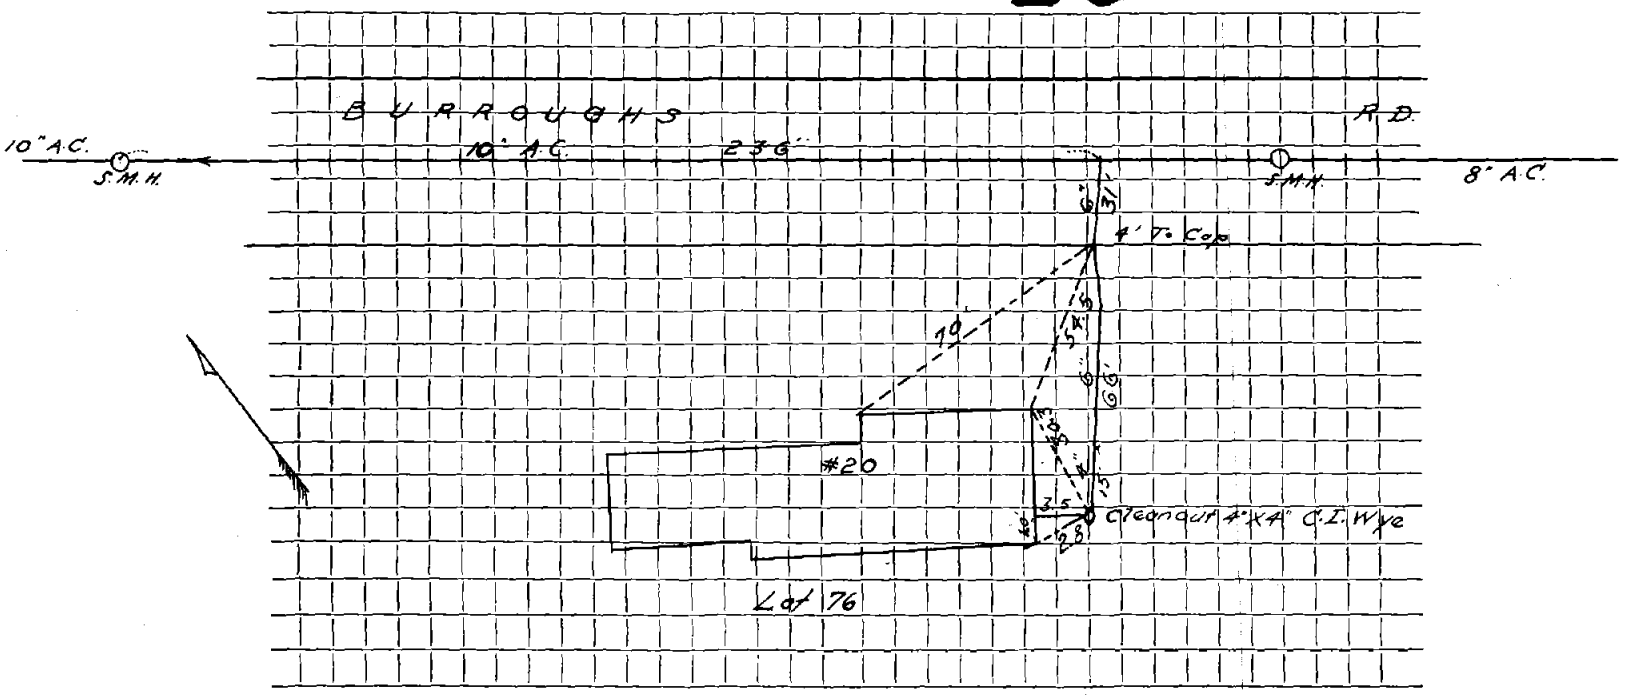

Connection made in ..... Street. Work completed .....

Remarks: .....

.....

.....