Name Permit **Service No.** 3633

Address 9 Burroughs RD

Location PG 62 - Lot 36A

Kind of Pipe PVC + AC **Size** 6" **Size of Main** 8" AC

Repair—Renewal—New Service J. McLaughlin **Location** PG62 - Lot 36A

Date		Material	Amount	Total	Date		Amount
4/28/10	2'	4" PVC					
	1 -	4" Clean out					
	4'	4" PVC					
	1	4 x 6 Ferneo					
	62'	6" PVC					
	1	6" PVC x AC Ferneo					
6-1968		Exist ST.					
	24.6'	6" Transite.					

DATE _____

TOWN OF LEXINGTON — BOARD OF PUBLIC WORKS

SEWER DIVISION

Sketch of Service Here

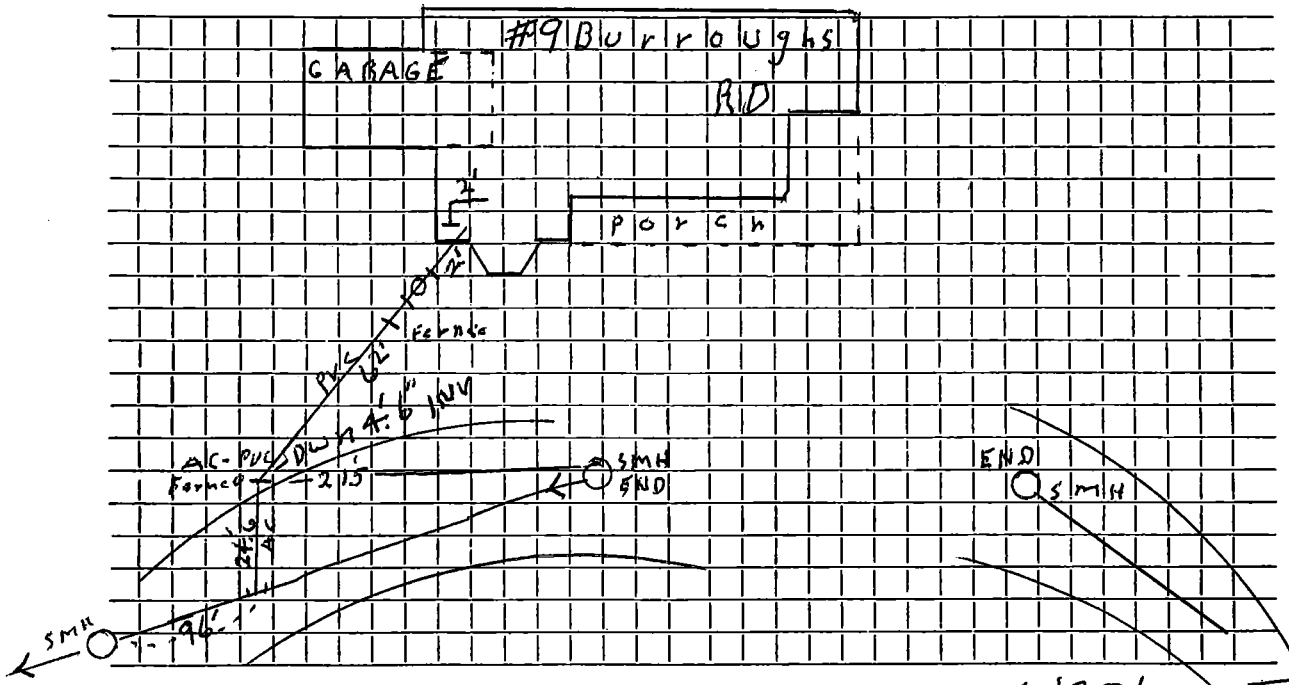

Connection made in ..... **Street.** **Work completed** 4/28/10 J. McL

Remarks: .....

.....

....