**Name** **Service No.**

**Address** 24 Butler Avenue (vacant lot)

**Location**

**Kind of Pipe** **Size** **Size of Main**

~~Repair Replacement~~—**New Service** W.O. #2876 **Location**

| Date | | Material | Amount | | Total | | Date | | | Amount | |
|---|---|---|---|---|---|---|---|---|---|---|---|
| 8-2-66/ 8-3-66 | | Labor | 50 | 80 | | | | | | | |
| | | 10% O.H. | 5 | 08 | 55 | 88 | | | | | |
| | 17' | 6" Transite pipe @ .88 | | | 14 | 96 | | | | | |
| | 1 | 6" Elbow | | | 4 | 09 | | | | | |
| | 1 | Hr. Trucking | | | 3 | 00 | | | | | |
| | 1 | Hr. Shovel | | | 6 | 50 | | | | | |
| | | | | | 84 | 43 | | | | | |
| | | (TO BE BILLED WHEN CONNECTED) | | | | | | | | | |

H.B.M.18501

DATE.....

# TOWN OF LEXINGTON — BOARD OF PUBLIC WORKS

## SEWER DIVISION

**Sketch of Service Here**

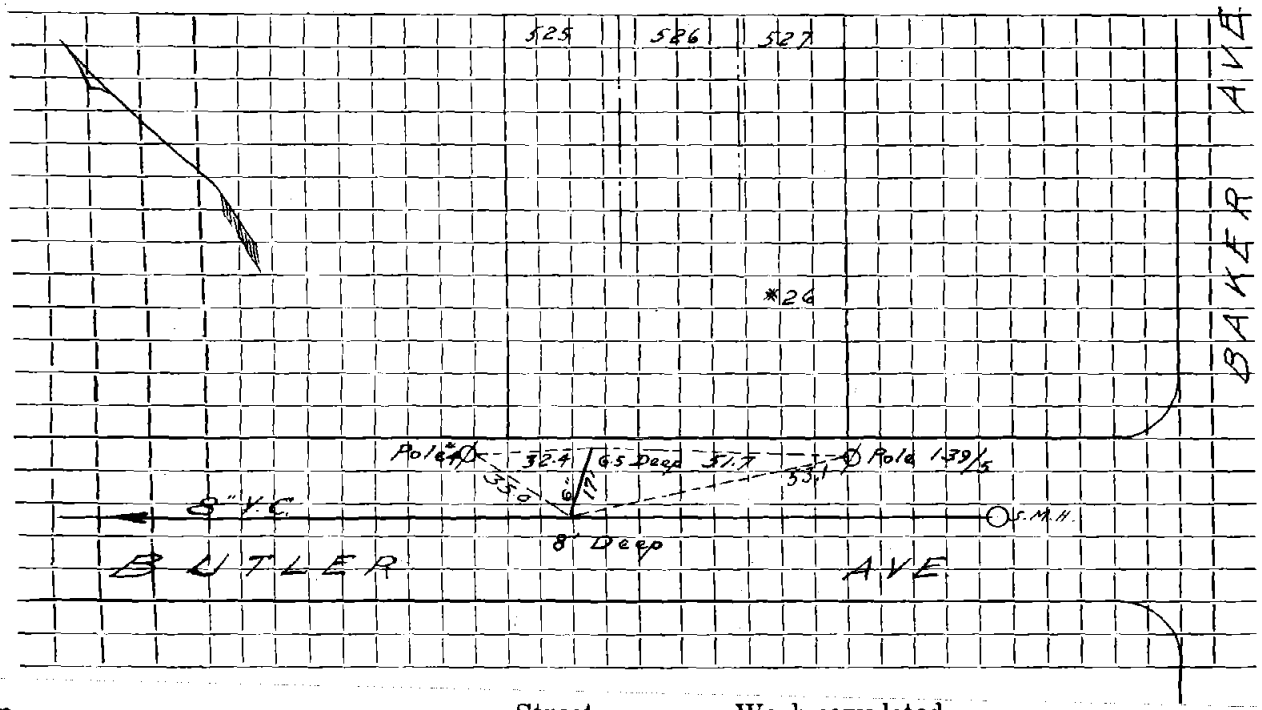


Connection made in ..... Street. Work completed .....

Remarks: .....

.....

.....