Name | **Service No.**

Address 24 CARRIAGE DR

Location

Kind of Pipe PVC | **Size** 6" | **Size of Main** 8"

Repair—Renewal—(New Service) | **Location**

Date		Material	Amount	Total	Date			Amount
~~6/23~~	~~88~~							
		~~PVC WYE~~						
		~~22½° BEND~~			6-23-88			
		~~11'6" PVC 6"~~				11.6	6" PVC	
1/24	89	45' 6"				1	6" X 8" Wye	
		FERN CO				1	6" - 22½° Bend	

DATE_____

TOWN OF LEXINGTON — BOARD OF PUBLIC WORKS

SEWER DIVISION

Sketch of Service Here **24**

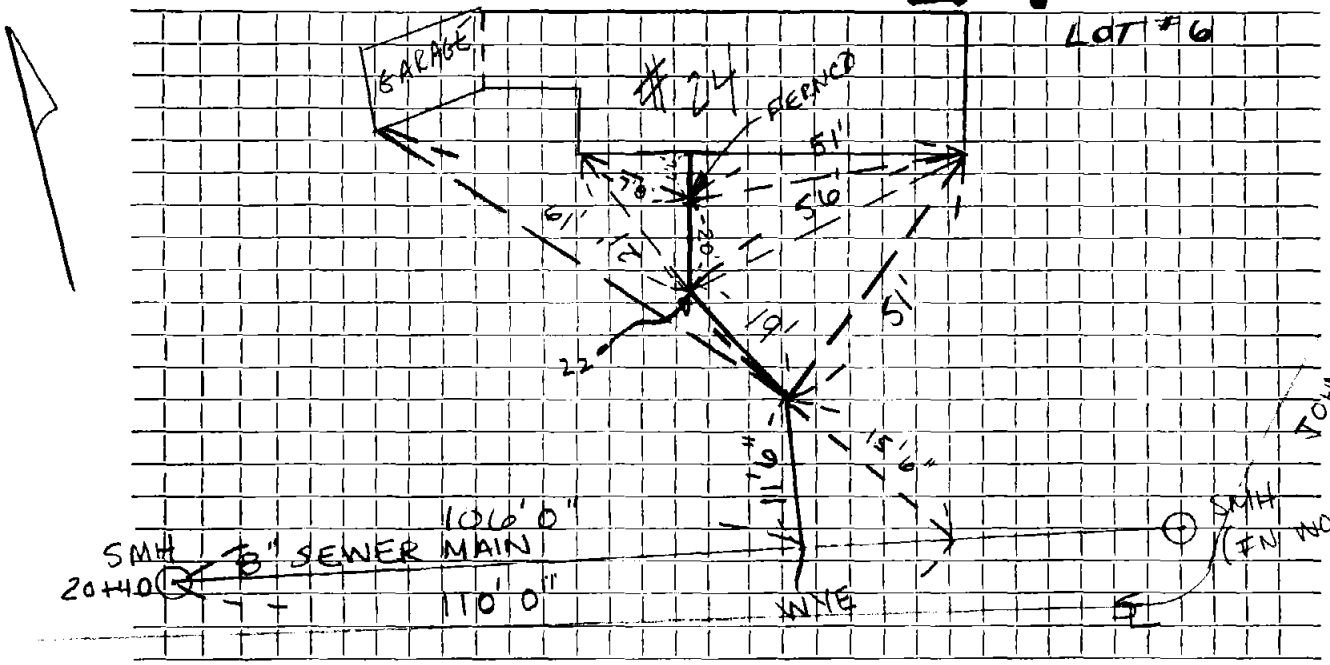

Connection made in ..... Street. Work completed .....

Remarks: .....

.....

....