Name Howard Margolis **Service No.** 63

Address 6 Carriage Drive

Location

Kind of Pipe **Size** **Size of Main**

~~Repair~~ ~~Renewal~~ **New Service** Valeri #3421 **Location** DEC 3 1979

Date		Material	Amount	Total	Date			Amount
~~7-11-75~~	~~20'~~	~~6" Transite Pipe @~~	$10.00	200.00	9-26-79		Deposit	200 00
10-2-79	129'	6" Transite Pipe						
	15'	4" Cast Iron pipe			7-11-	75		
						20'	6" Transite	

E.B.M.18501

DATE _____

TOWN OF LEXINGTON — BOARD OF PUBLIC WORKS

SEWER DIVISION

Sketch of Service Here 6

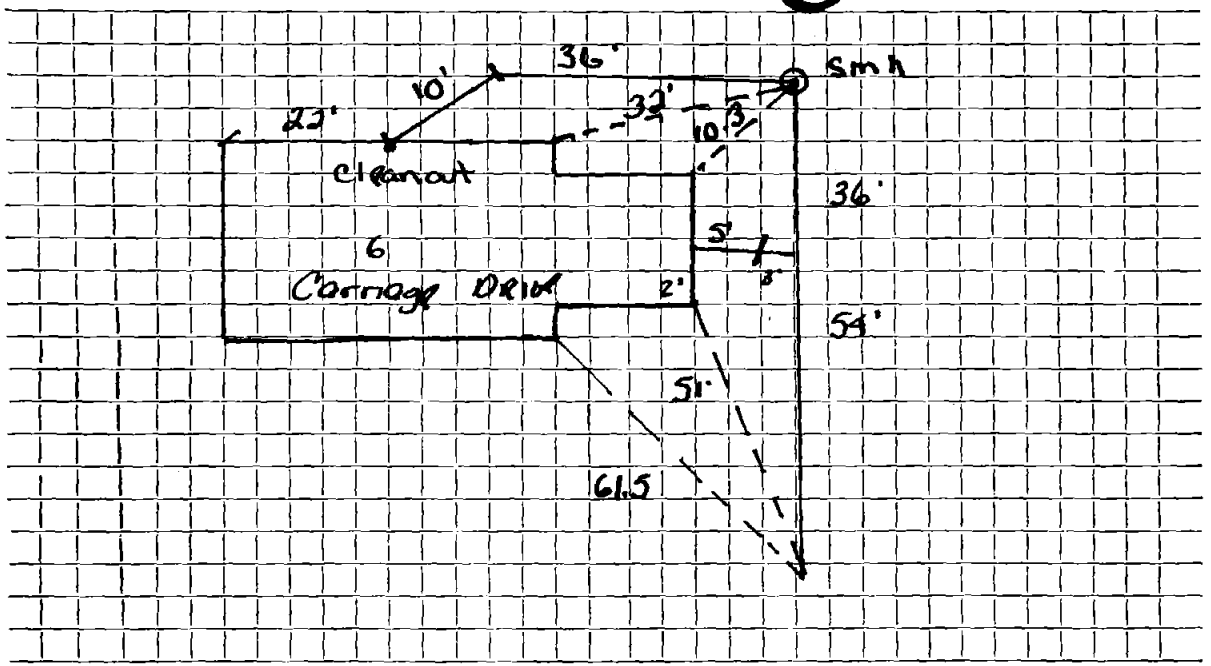

Connection made in ..... Street. Work completed .....

Remarks: .....

.....

....