Name

Service No. 363

Address 3 Cart Path Lane

Location Lot 1.K

Kind of Pipe

Size

Size of Main

Repair—Renewal—New Service J. Mclaughlin

Location

Date		Material	Amount	Total	Date		Amount
5/2/10	37'	6" PVC sch 40					
	6'	4" PVC					
	1	4X6 Fernco					
2008	Exist	STub-PVC. Down 6.0'					

DATE_____

TOWN OF LEXINGTON — BOARD OF PUBLIC WORKS

SEWER DIVISION

Sketch of Service Here

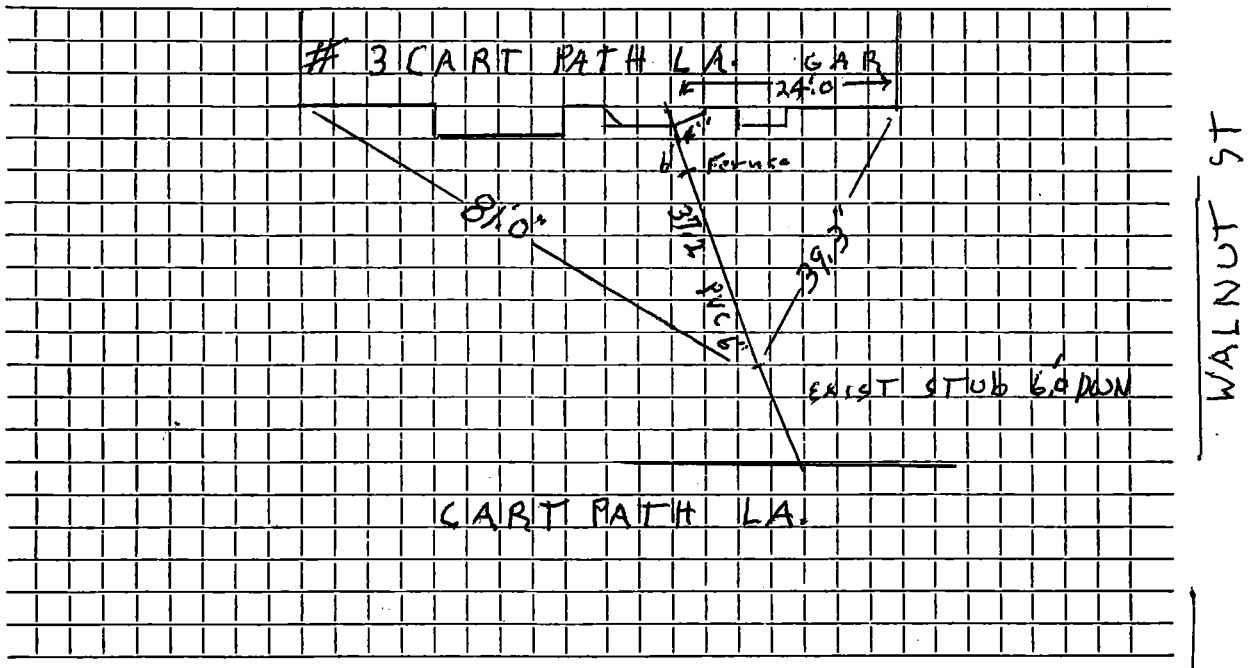

Connection made in ..... **Street.** **Work completed** 5/2/10

Remarks: .....

.....

....