Name **Service No.**

Address 16 CARY AVE

Location

Kind of Pipe PVC **Size** 6" **Size of Main** 8"

Repair—Renewal—New Service **Location**

Date	Material	Amount	Total	Date		Amount
				10-5-99		
					19' 6" PVC	

DATE 10-5-99

TOWN OF LEXINGTON — BOARD OF PUBLIC WORKS

SEWER DIVISION

Sketch of Service Here

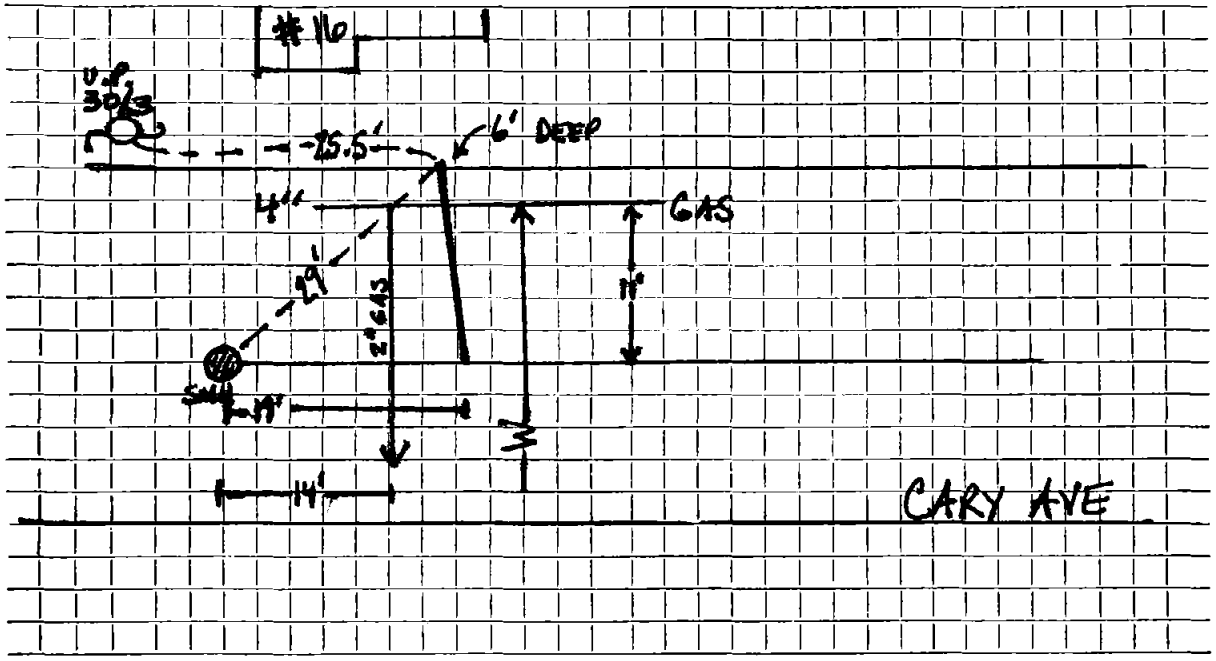

Connection made in ..... Street. Work completed .....

Remarks: WATER SERVICE ~ 4' DOWN
2" GAS SERVICE ~ 3' DOWN / 4" HP GAS MAIN 1.5' DOWN
FIELD BOOK 99-12-1 : PG 16

D.F.