Name

Service No.

Address 17 CARY AVE

Location

Kind of Pipe PVC

Size 6"

Size of Main 8"

Repair—Renewal—New Service RENEWAL PROJECT 99-12

Location

Date	Material	Amount	Total	Date		Amount
				10-6-99		
					20' 6" PVC	

DATE 10-6-99

TOWN OF LEXINGTON — BOARD OF PUBLIC WORKS

SEWER DIVISION

Sketch of Service Here

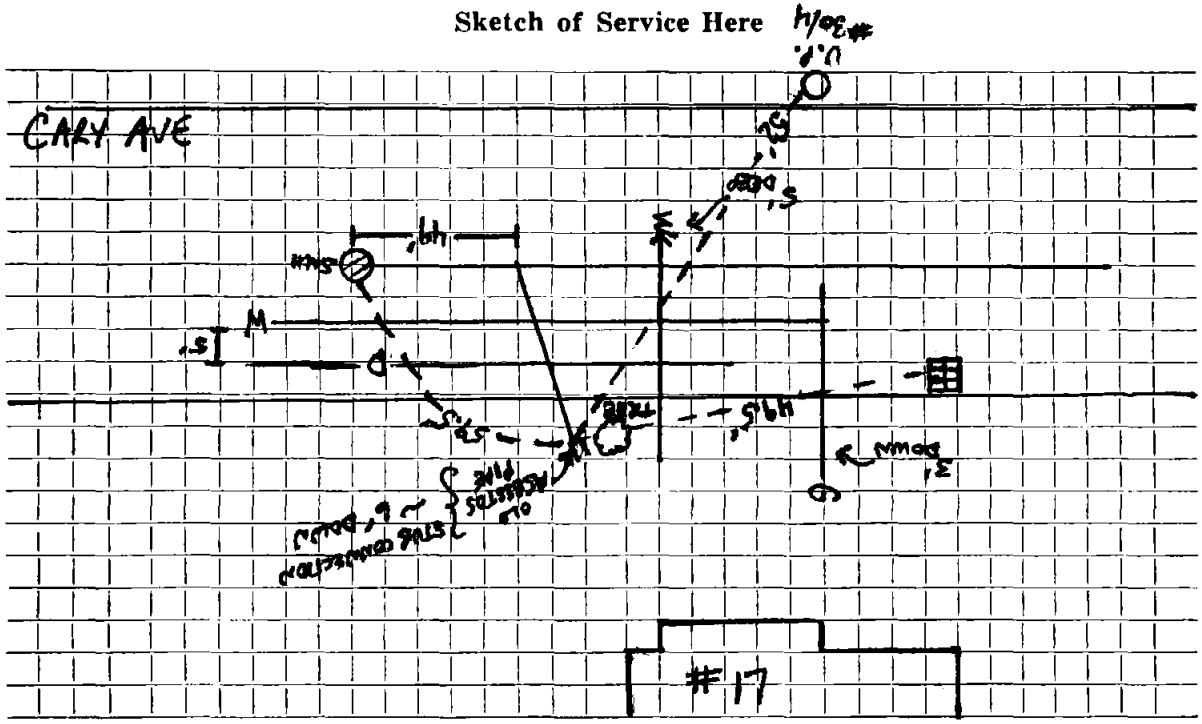

Connection made in ..... Street. Work completed .....

Remarks: STUB END ~ 6' DOWN

DRAIN ABOVE SEWER, 3-5' DOWN FROM PAVEMENT

WATER MAIN ABOVE SEWER SERVICE, 5' DOWN FROM PAVEMENT

FIELD BOOK 99-12-1 PG 18

D.F.