Name **Service No.** 2031

Address 31 Cary Ave

Location

Kind of Pipe PVC **Size** 6" **Size of Main**

Repair—Renewal—New Service J McLaughlin **Location**

Date		Material	Amount	Total	Date		Amount
2/8/06	6.0	4" Sch 40					
	28'	6" PVC					
		22° bend					
	1	4x6 Fernco					
	1	8x6 wye+22° bend					
	INV.	Stub 7' down					

DATE_____

TOWN OF LEXINGTON — BOARD OF PUBLIC WORKS

SEWER DIVISION

Sketch of Service Here

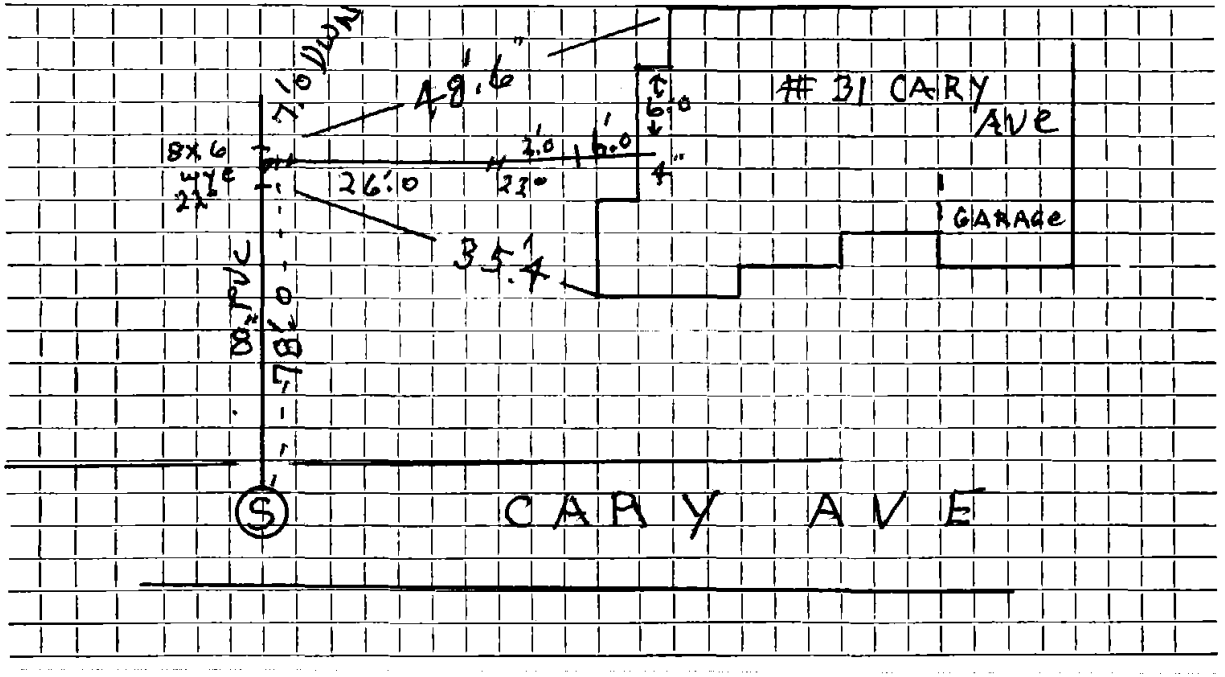

Connection made in ..... Street. Work completed .....

Remarks: .....

.....

.....